SEC. 9 T.28S. R. 7W W.M.
DOUGLAS COUNTY

**Scale: 1" = 1000'**

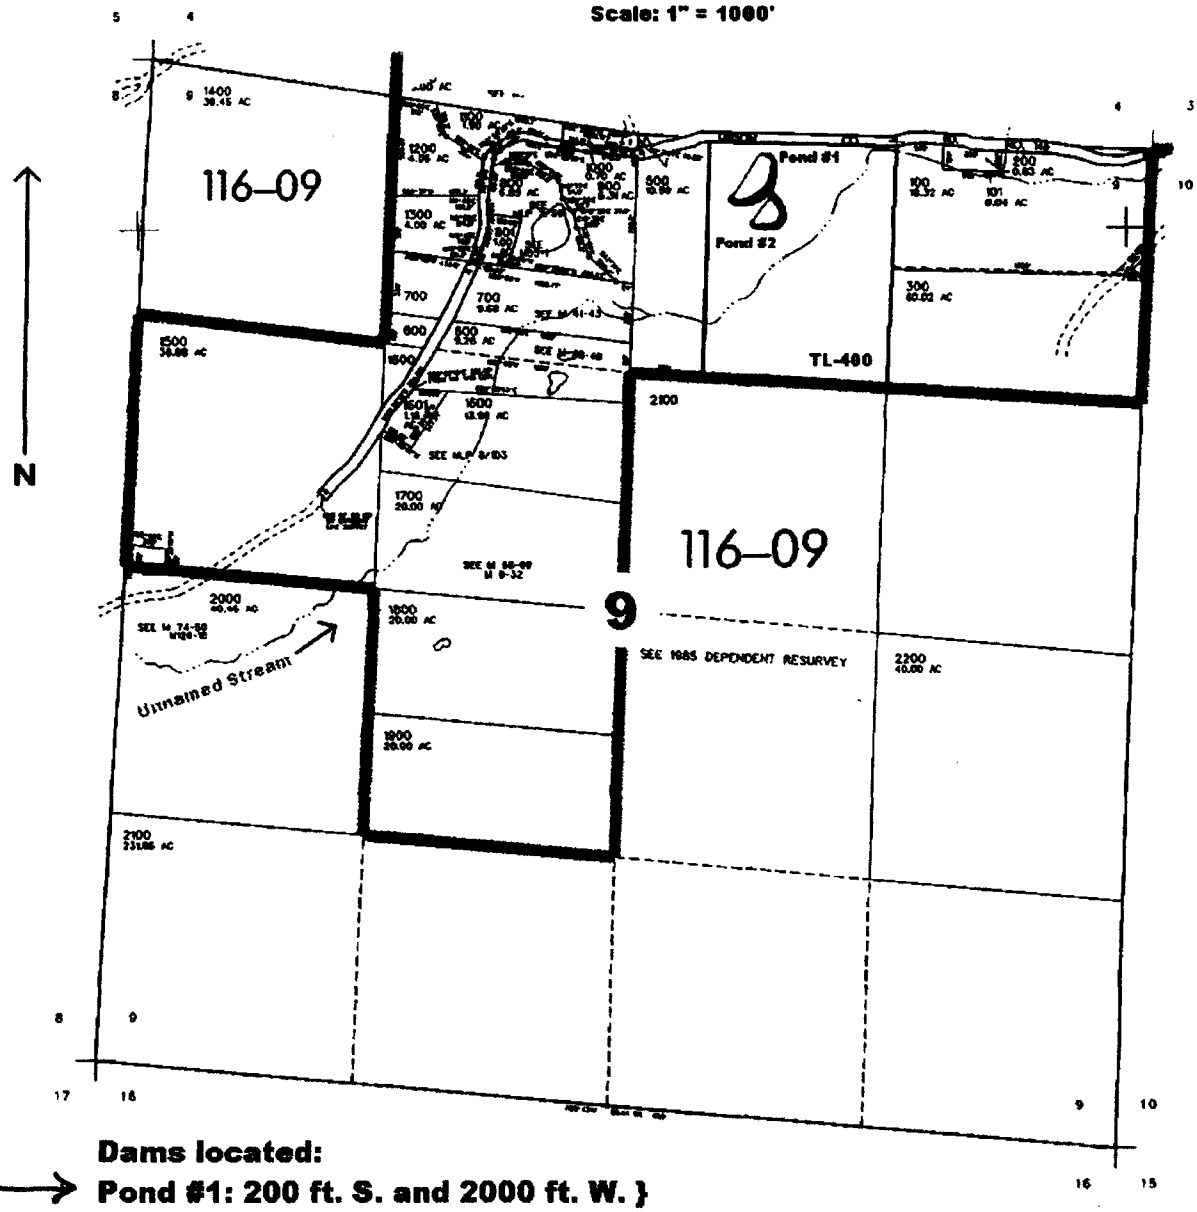


**Dams located:**

→ **Pond #1: 200 ft. S. and 2000 ft. W. }**

**Pond #2: 400 ft. S. and 1950 ft. W. } from the NE corner of Sec. 9**

app no R-85693
Permit no R-13781

RECEIVED
JUL 07 2003
WATER RESOURCES DEPT.
SALEM, OREGON