THIS MAP WAS PREPARED FOR ASSESSMENT PURPOSE ONLY

SW1/4 SEC. 10 T30S. R.4W. W.M.
DOUGLAS COUNTY

REVISED ON 3-26-94

30 4 10C & INDEX

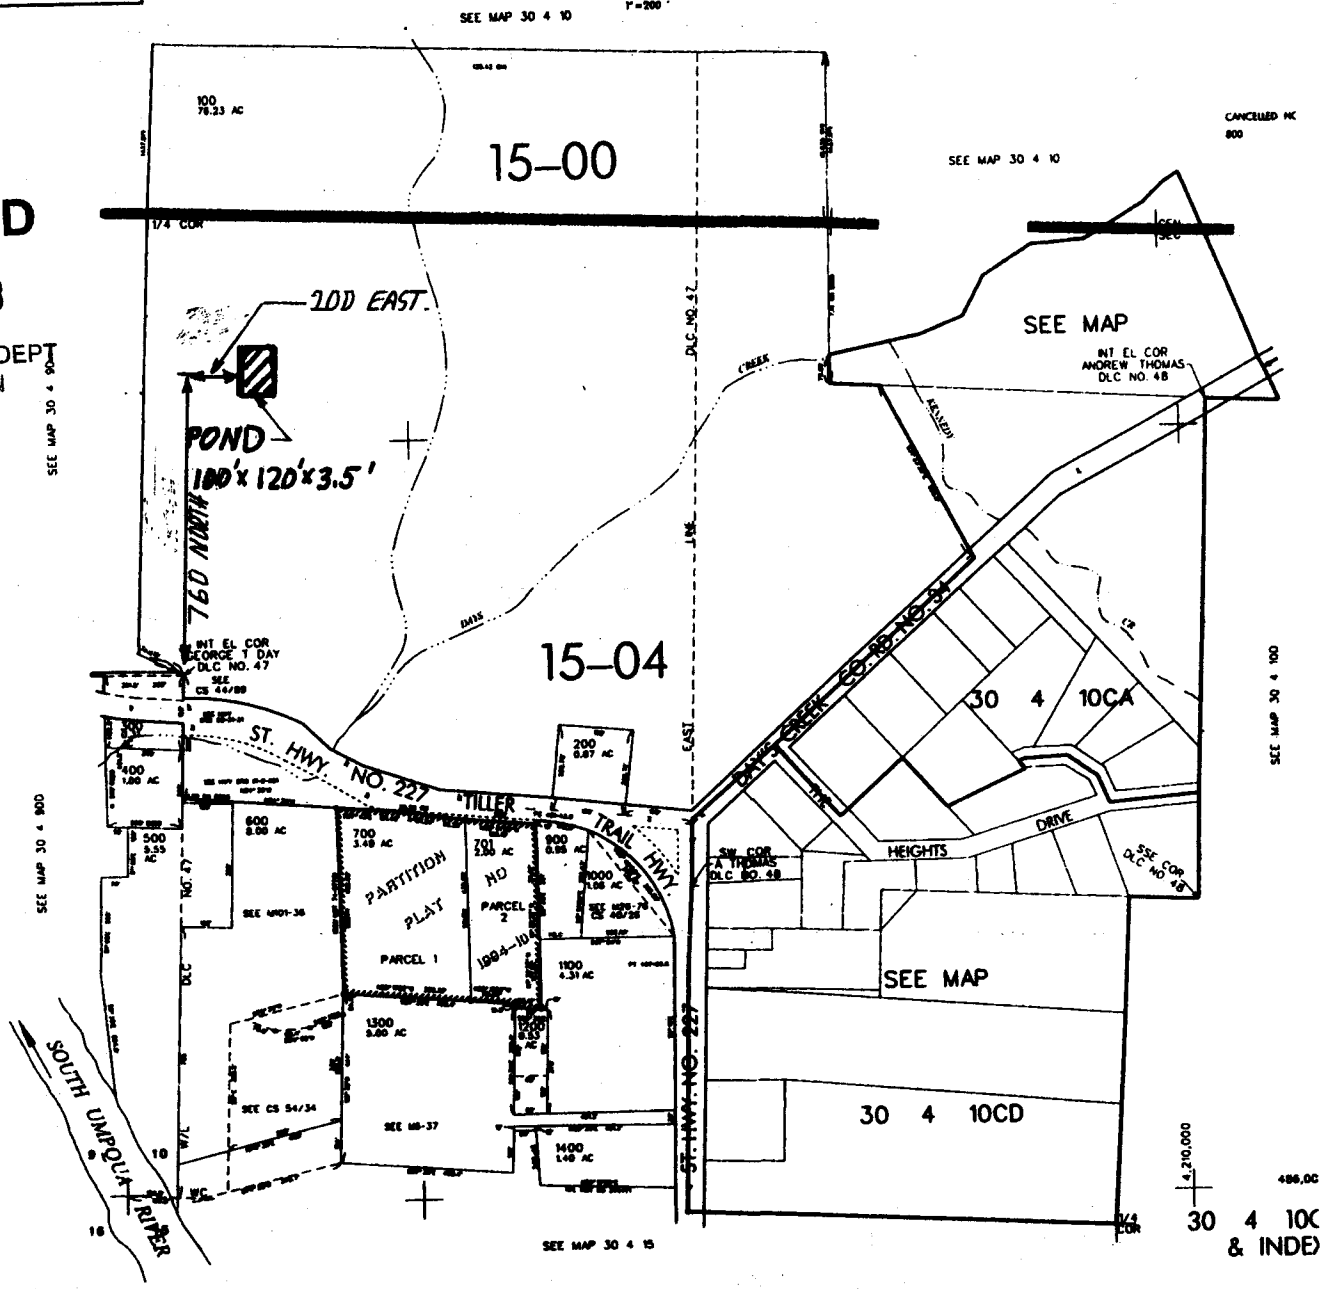

RECEIVED
DEC 09 2003
WATER RESOURCES DEPT
SALEM, OREGON

RECEIVED
JUL 23 2003
WATER RESOURCES DEPT.
SALEM, OREGON

SCALE 1" = 500'

POND IS LOCATED 760 FEET NORTH AND 200 FEET EAST FROM THE INT. EL. COR. GEORGE T DAY, DLC # 47.

app no R-85714 Permit no R-13790