RECEIVED
JUL 2 8 2003
WATER RESOURCES DEPT
SALEM, OREGON

SEC. 34 T.26S. R.7 W W.M.
DOUGLAS COUNTY
Scale: 1" = 1000'

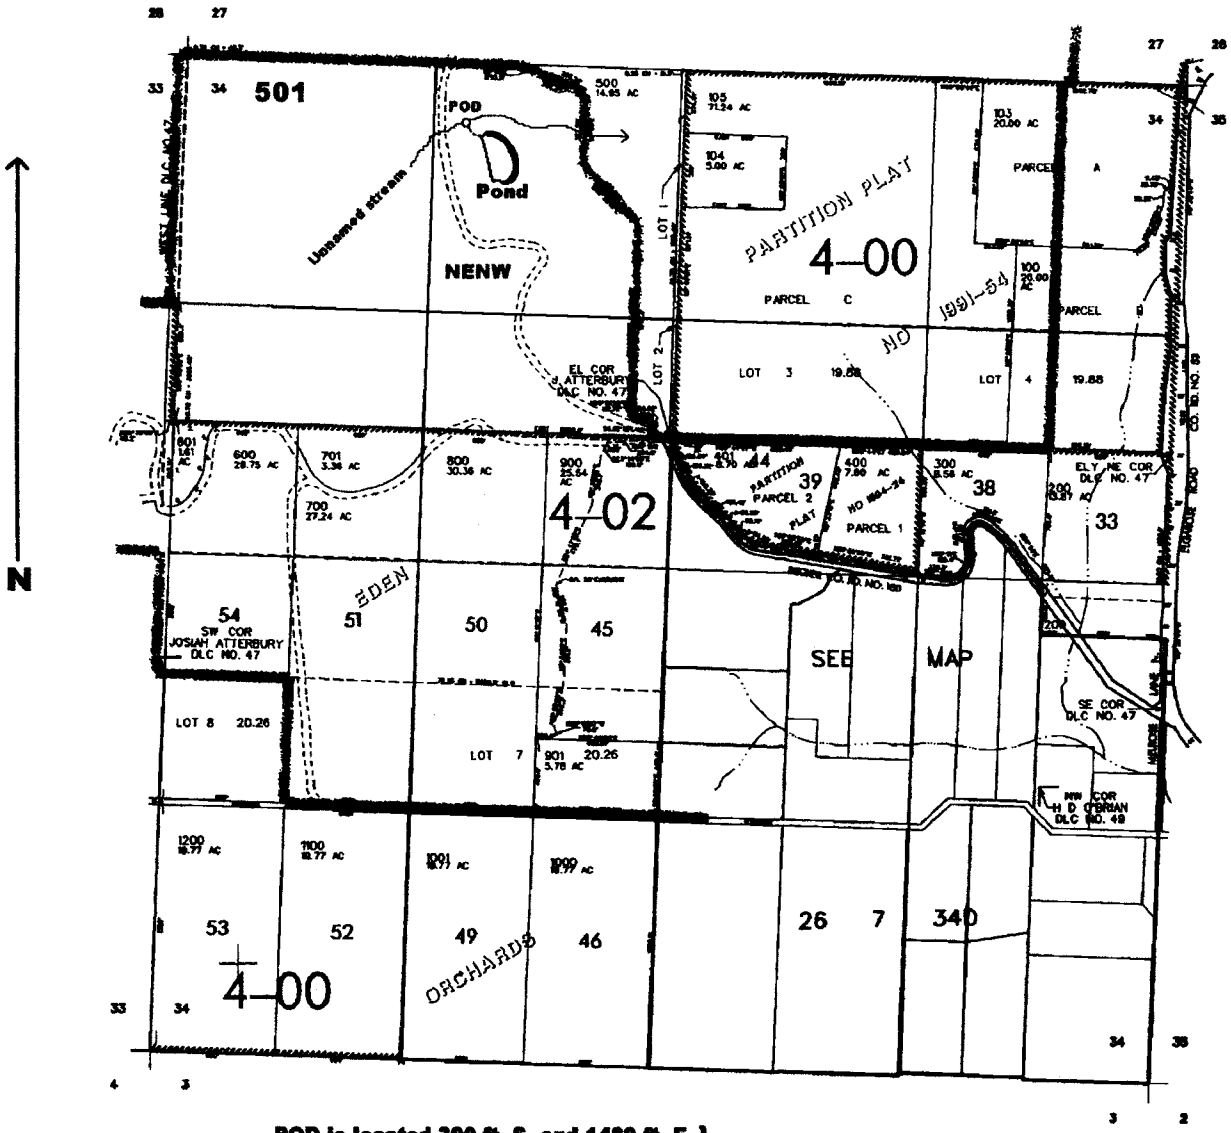

POD is located 300 ft. S. and 1480 ft. E. }
Dam is located 450 ft. S. and 1750 ft. E. } **from the NW corner of Sec. 34**

app-no R-85719
Permit no R-13791