

APP NO  
R-85738  
Permit NO  
R-13797





NOTICE: ALL FEATURES LOCATED WITHIN THE HIGHLIGHTED PUBLIC RIGHT OF WAY ARE SUBJECT TO THE TERMS OF THE PUBLIC RIGHT OF WAY. THE HIGHLIGHTED PUBLIC RIGHT OF WAY IS NOT TO BE CONSIDERED AS A PART OF THE SURVEY.

NOTICE: This map was created for Assessor's Office use ONLY.



SCALE 1" = 400'  
Created: February 12, 2003

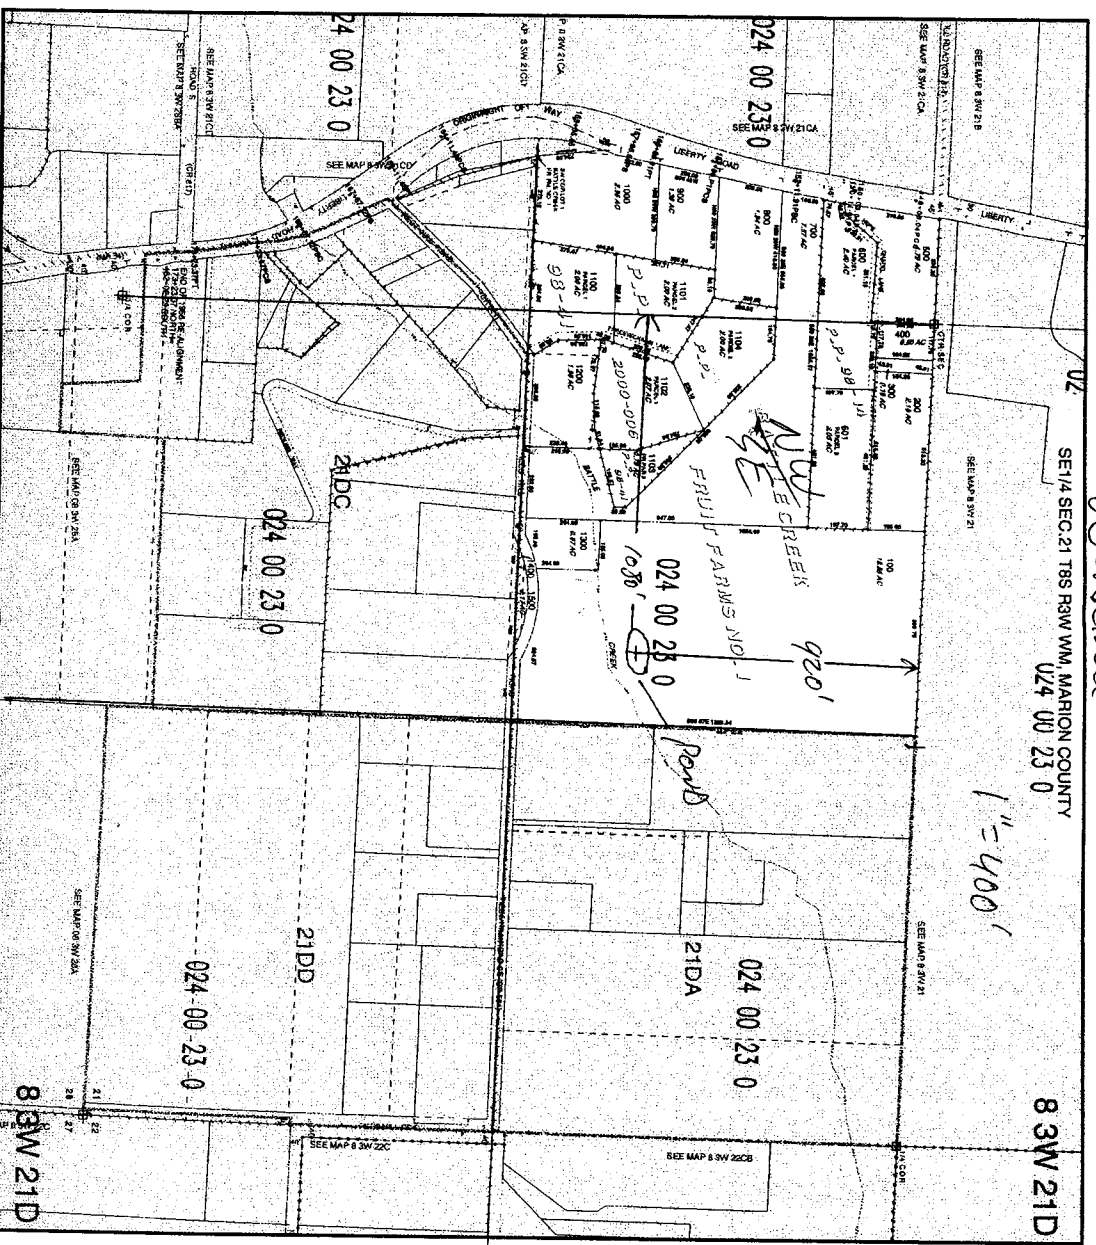

*WORKING*

1" = 400'

*Legend ⊕ Pond*