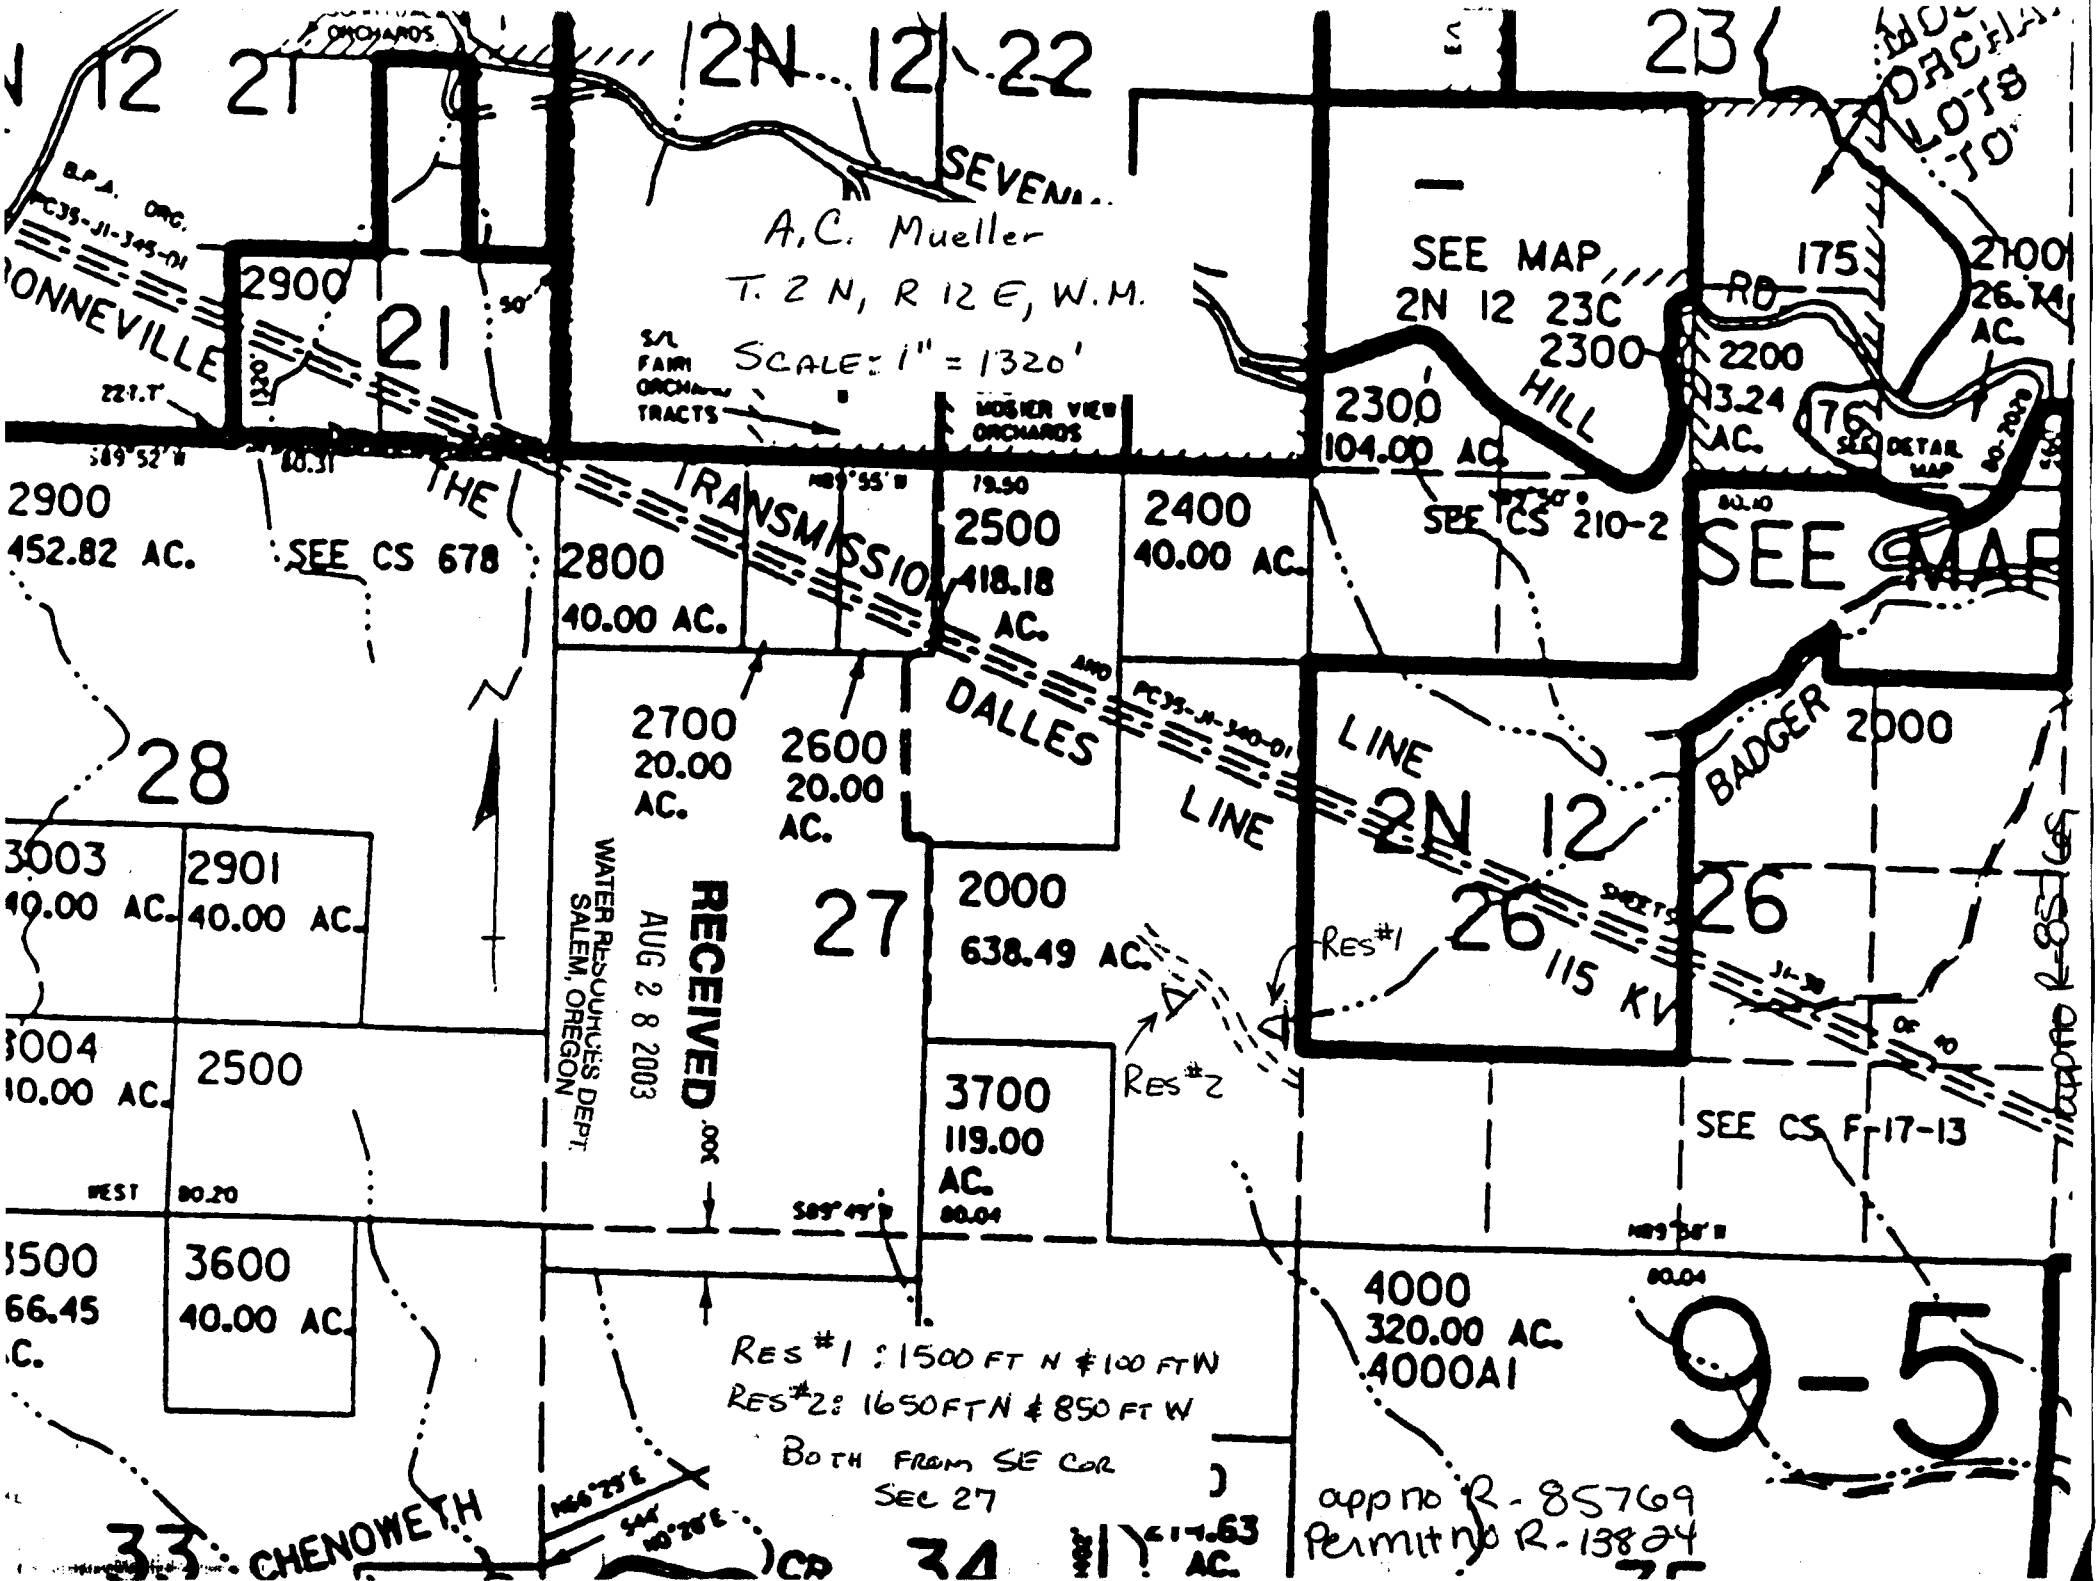

A.C. Mueller
T. 2 N, R 12 E, W.M.
SCALE: 1" = 1320'
2N 12 22
23
21
SEVEN
BONNEVILLE
THE TRANSMISSION
DALLES LINE
LINE
2N 12
26
115 KV
BADGER
SEE MAP
2N 12 23C
2300
HILL
2300
104.00 AC.
2200
13.24 AC.
2100
26.74 AC.
175
176
SEE DETAIL MAP
SEE CS 210-2
SEE MAP
2900
452.82 AC.
SEE CS 678
2800
40.00 AC.
2500
418.18 AC.
2400
40.00 AC.
2700
20.00 AC.
2600
20.00 AC.
2000
638.49 AC.
3700
119.00 AC.
40.00 AC.
2901
40.00 AC.
2500
3600
40.00 AC.
4000
320.00 AC.
4000A1
SEE CS F-17-13
Res #1
Res #2
RECEIVED
AUG 2 8 2003
WATER RESOURCES DEPT.
SALEM, OREGON
Res #1: 1500 FT N & 100 FT W
Res #2: 1650 FT N & 850 FT W
Both from SE Cor
Sec 27
app no R-85769
Permit no R-13824
9-5
CHENOWETH
33
34