


NE COR OF SW COR SECTION 32 T 85 R 2W
 TAXLOT 082W32 601 & 500
 CENTER OF DAM: UTM NAD-83 METERS (ZONE 10)
 N 4,964,076
 E 503,097

DAM / RESERVOIR LOCATION

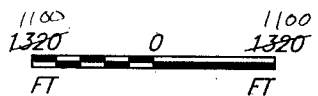

APP. R-85547
 PER. R-13825

RECEIVED
 APR 07 2003
 WATER RESOURCES DEPT.
 SALEM, OREGON

Sheet 1 of 1

ORLWCS-0305
 Drawing No.

File Name

Natural Resources Conservation Service
 United States Department of Agriculture

McKinney Creek WRP
 LOCATION MAP
 ORS 537.409 PERMITTING
 Marion County, OR

	Date
Designed: CMS	3/03
Drawn: CMS	3/03
Checked:	
Approved:	
Title:	