


RECEIVED

SEP 22 2003

WATER RESOURCES DEPT
SALEM, OREGON

T. 3 S., R. 3 E. W.M.

Map for Roger & Kathleen Campbell
18958 S. Mattoon
Clacada, Ore 97123
phone 503-631-2127

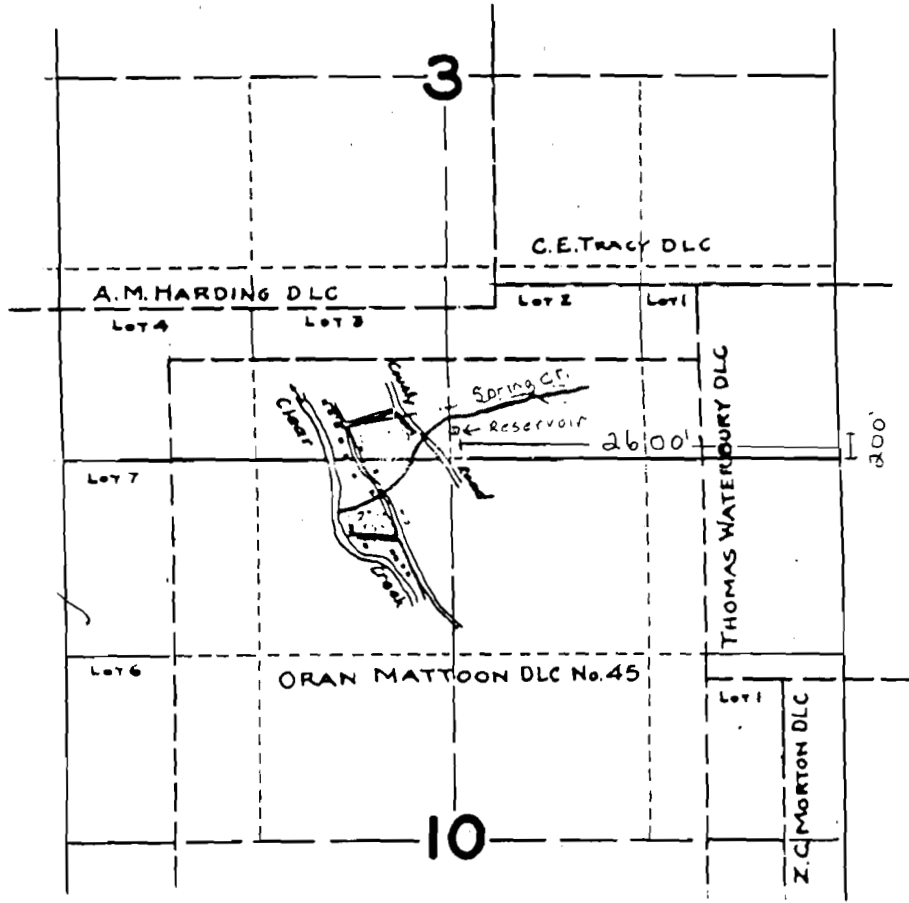

Reservoir is located 200' North and 2600'
West of the SE Corner, Sec. 3, T. 3 S., R. 3 E

1" = 1320 FT

App No R-85505
Permit No R-13853