


WORK COPY
SEC. 18S R6W WM
POLK COUNTY

IMPORTANT
This Map for Assessment
and Taxation Purposes
ONLY

Scale 1" = 400'

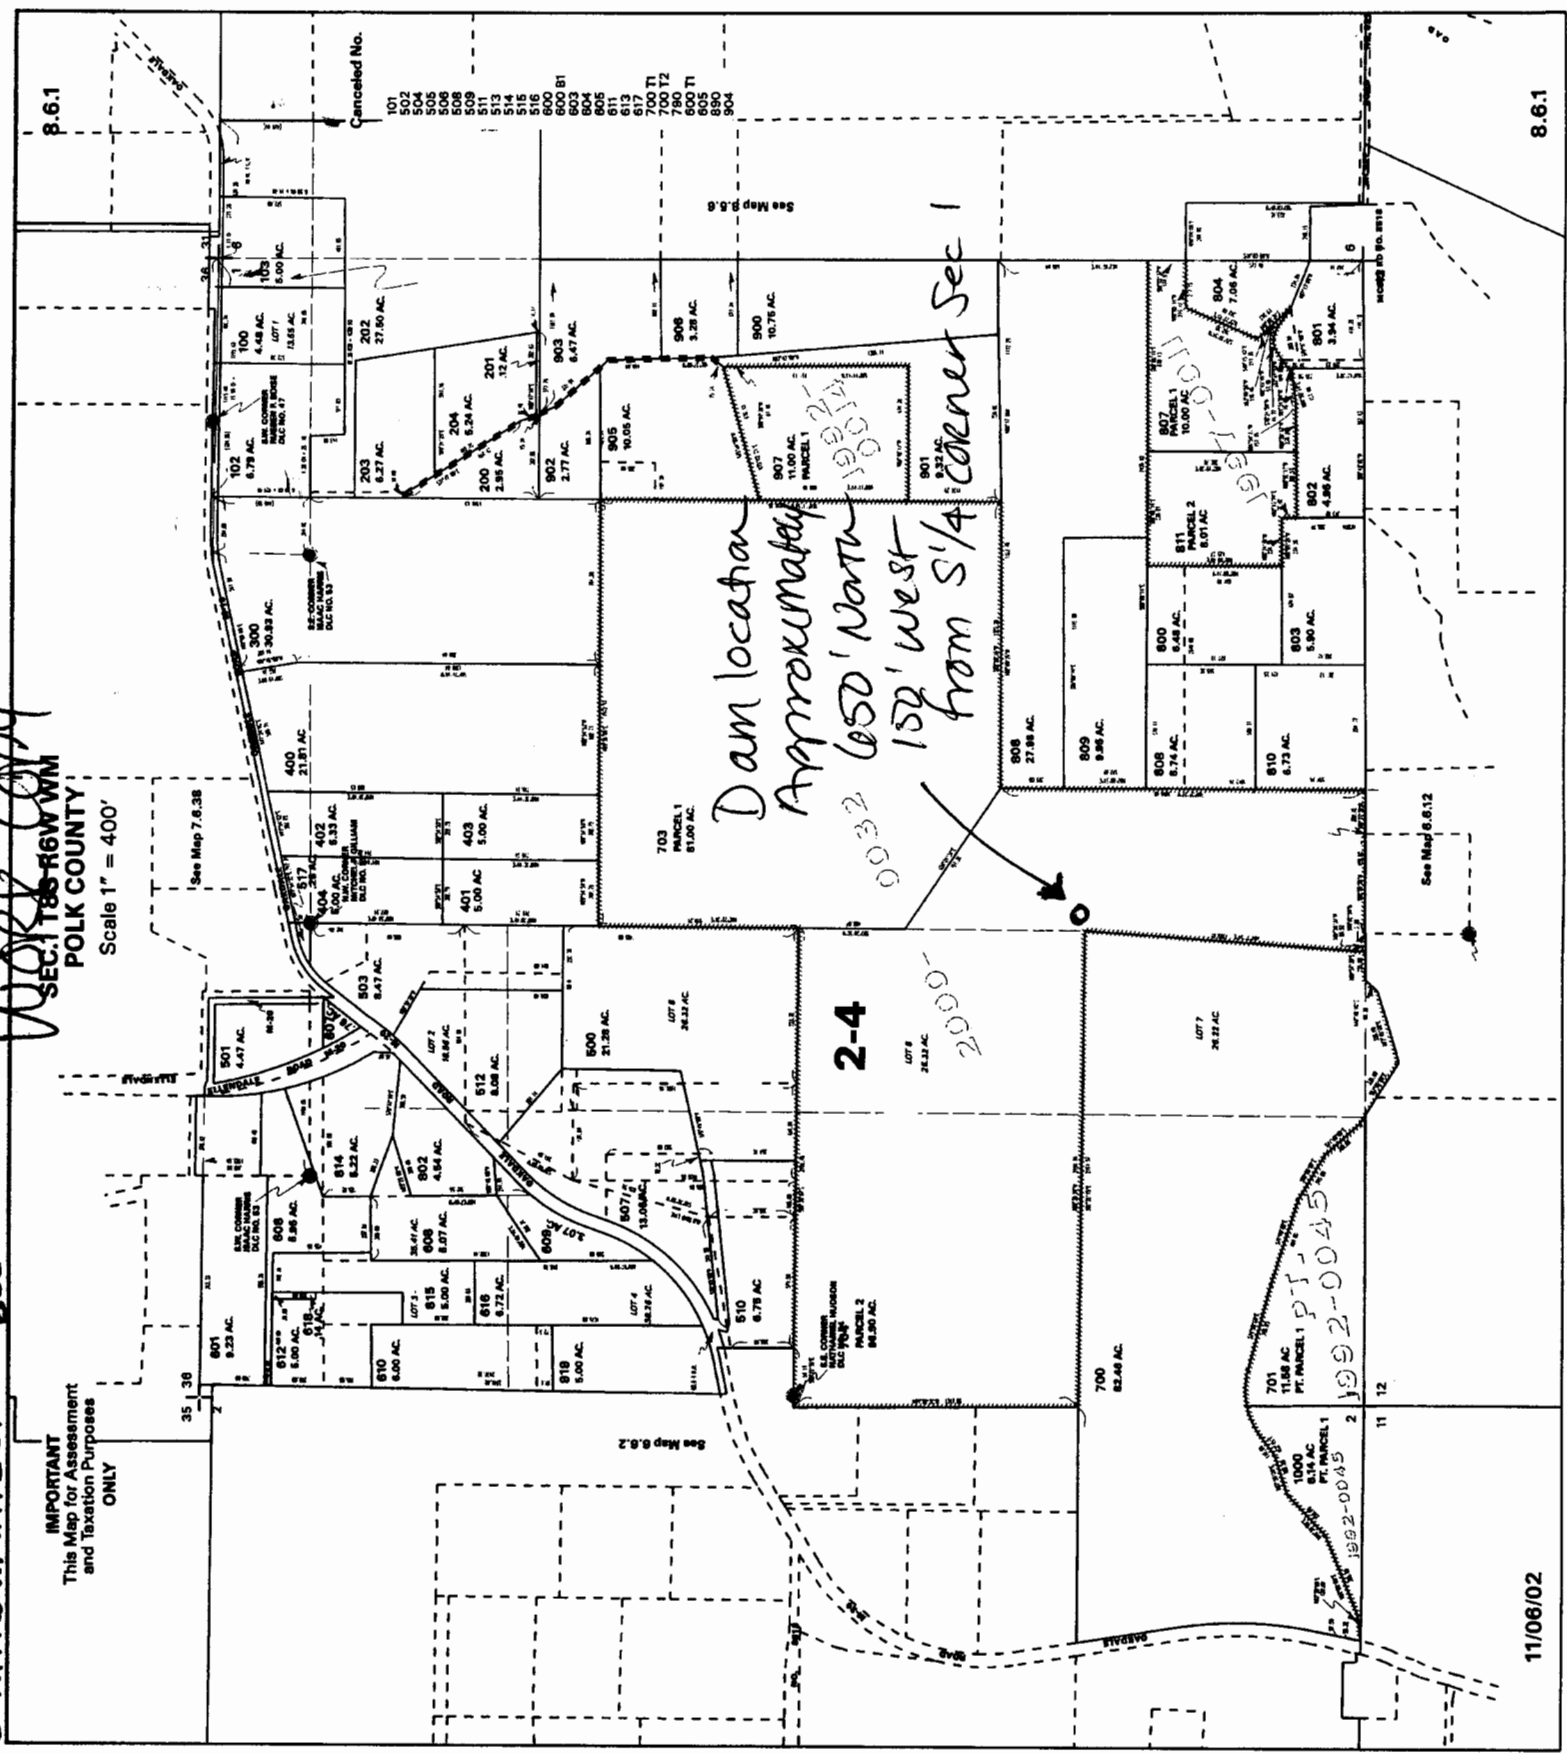

AppNo R-85759 Permit no R-13875

11/06/02