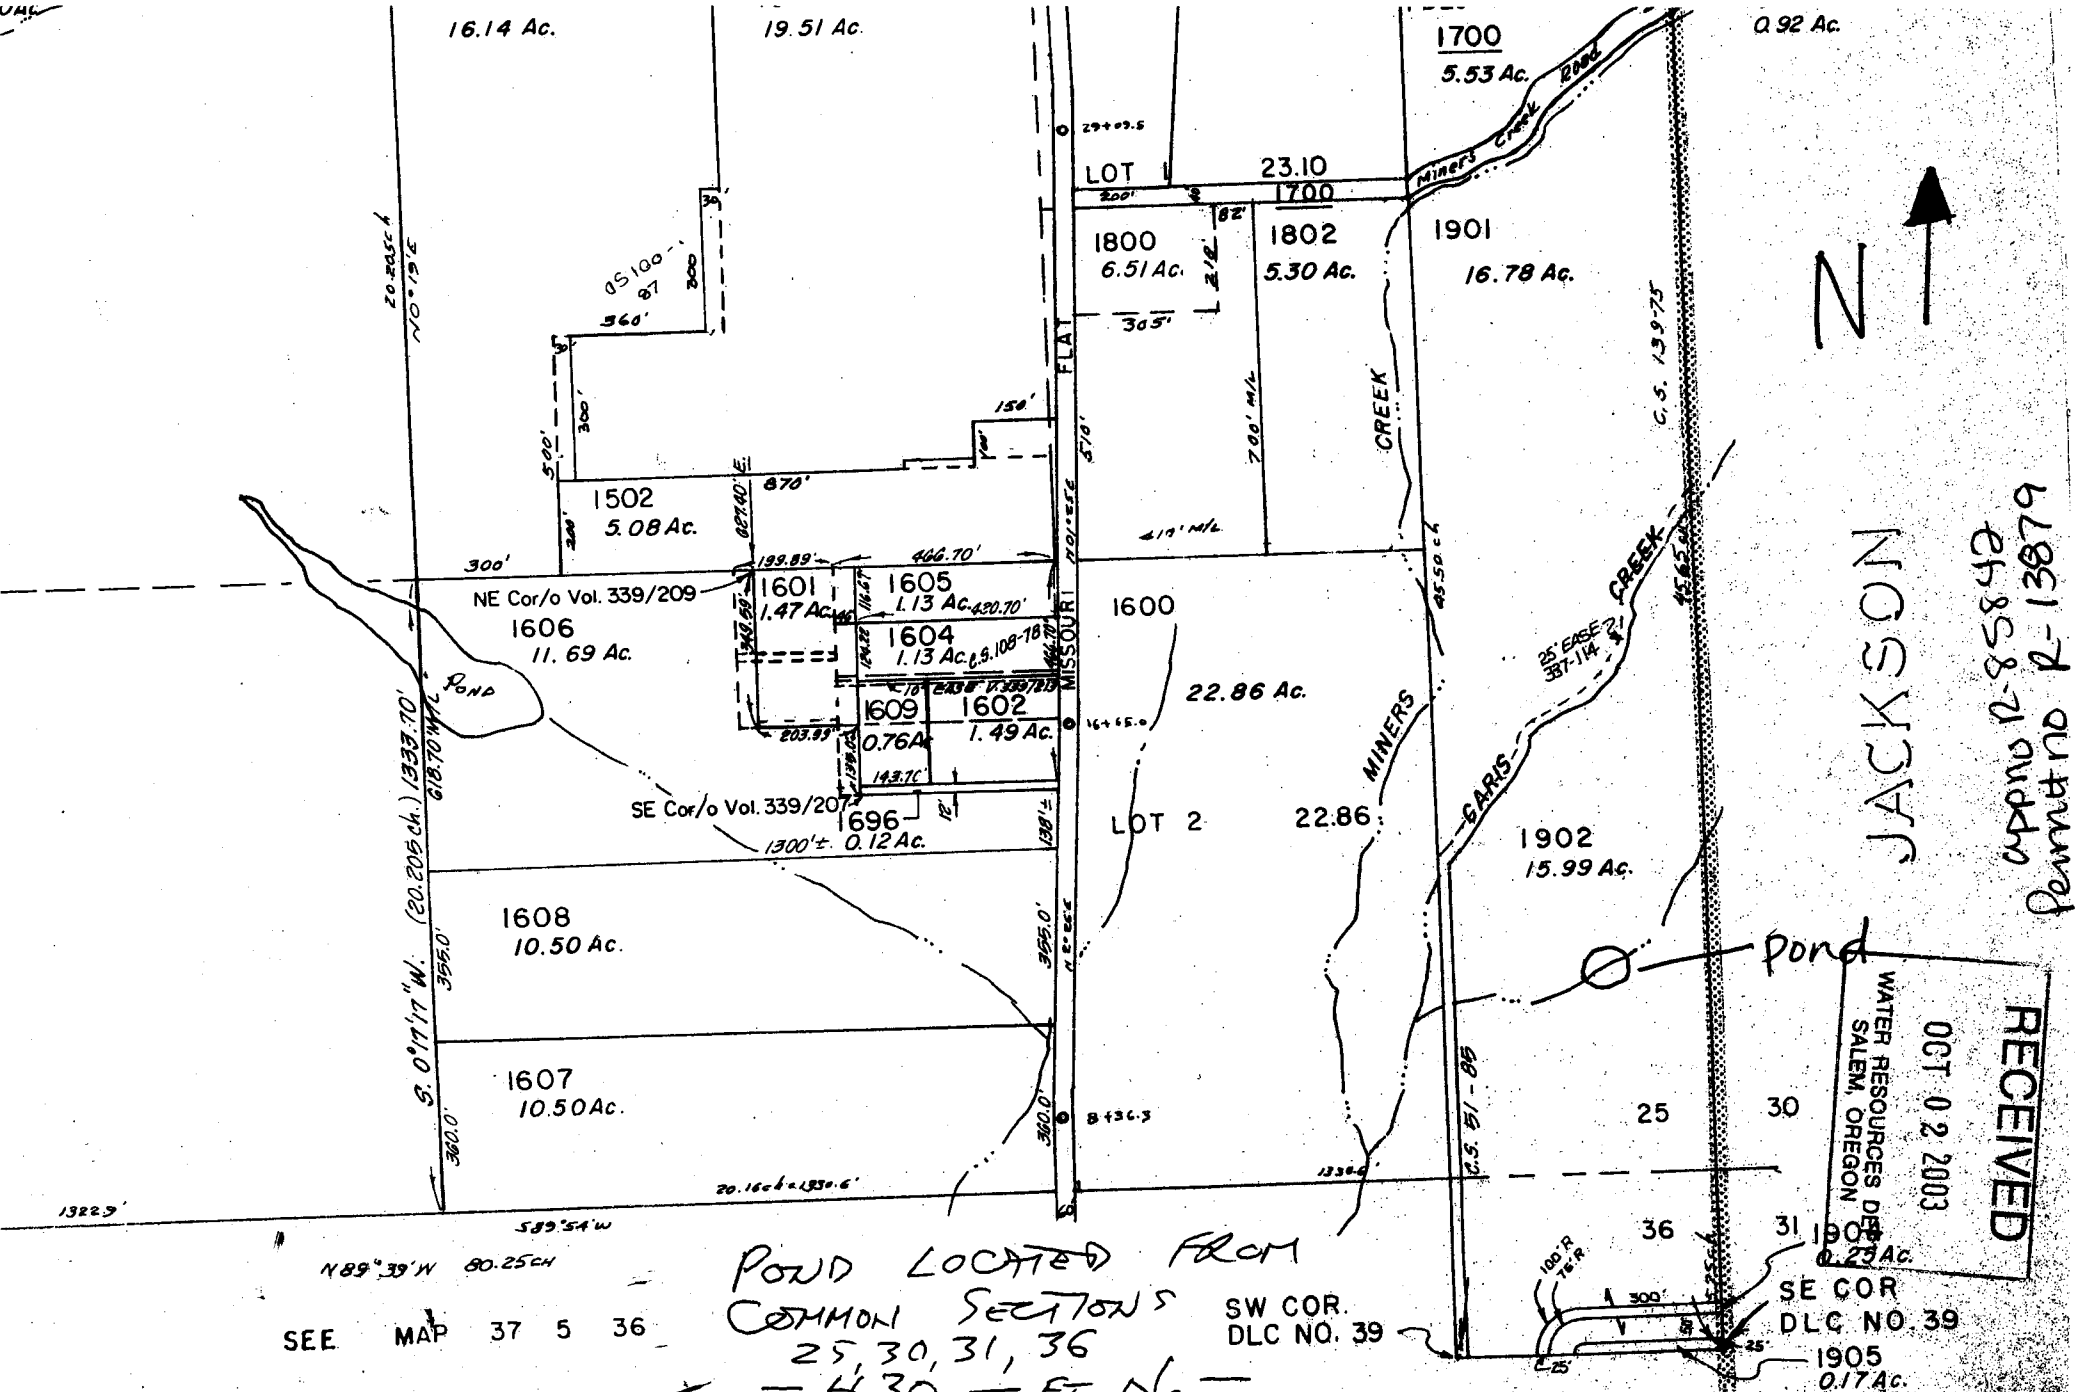

JACKSON

appno R-85842
Permit no R-13879

RECEIVED
OCT 02 2003
WATER RESOURCES DEPT
SALEM, OREGON

POND LOCATED FROM
COMMON SECTIONS
25, 30, 31, 36
— 430 — FT N. —
— 240 — FT W. —

SCALE
1" = 400'

37s-5w-25