


Johnson Map
 Compared from information
 Provided by Applicant

Center of Pond
 430' N & 90' E. from
 SE cor, LOUIS HERGAS
 OLC #70

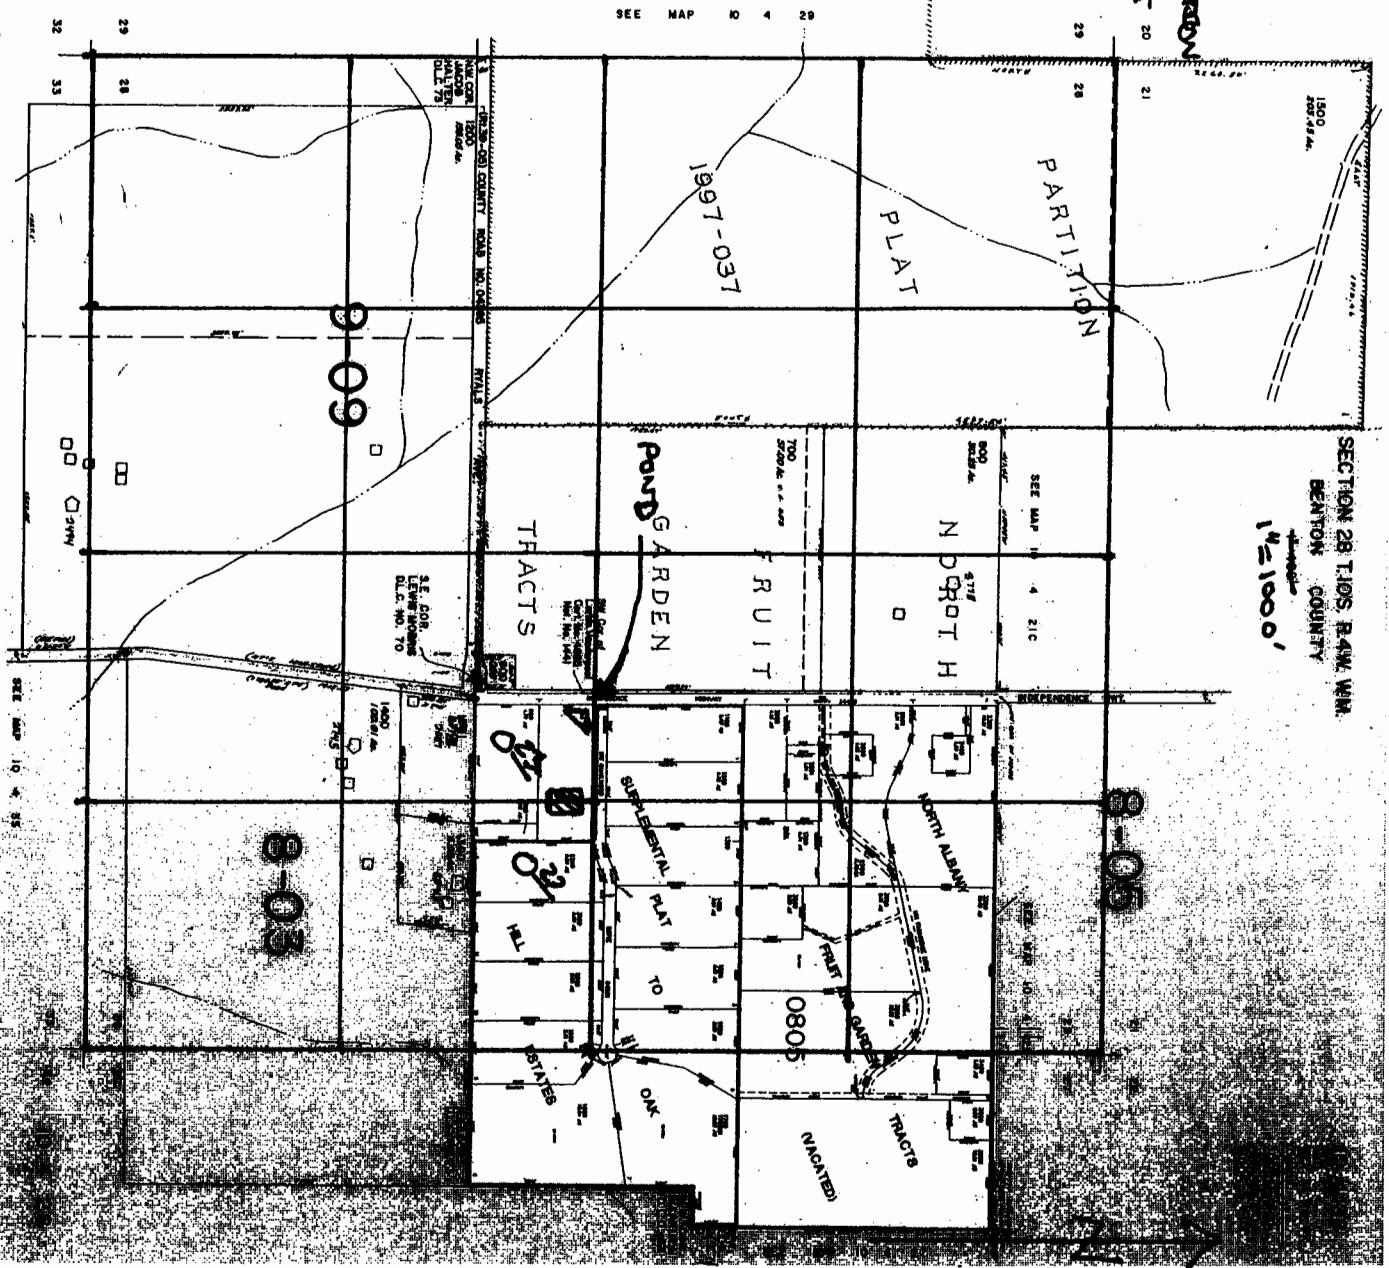

app no R-85865
 permit no R-13894