

Ridder

Township 2 South, Range 38 East


Scale 1" = 400'

RECEIVED

DEC 05 2003

WATER RESOURCES DEPT
SALEM, OREGON

CS 003-2000

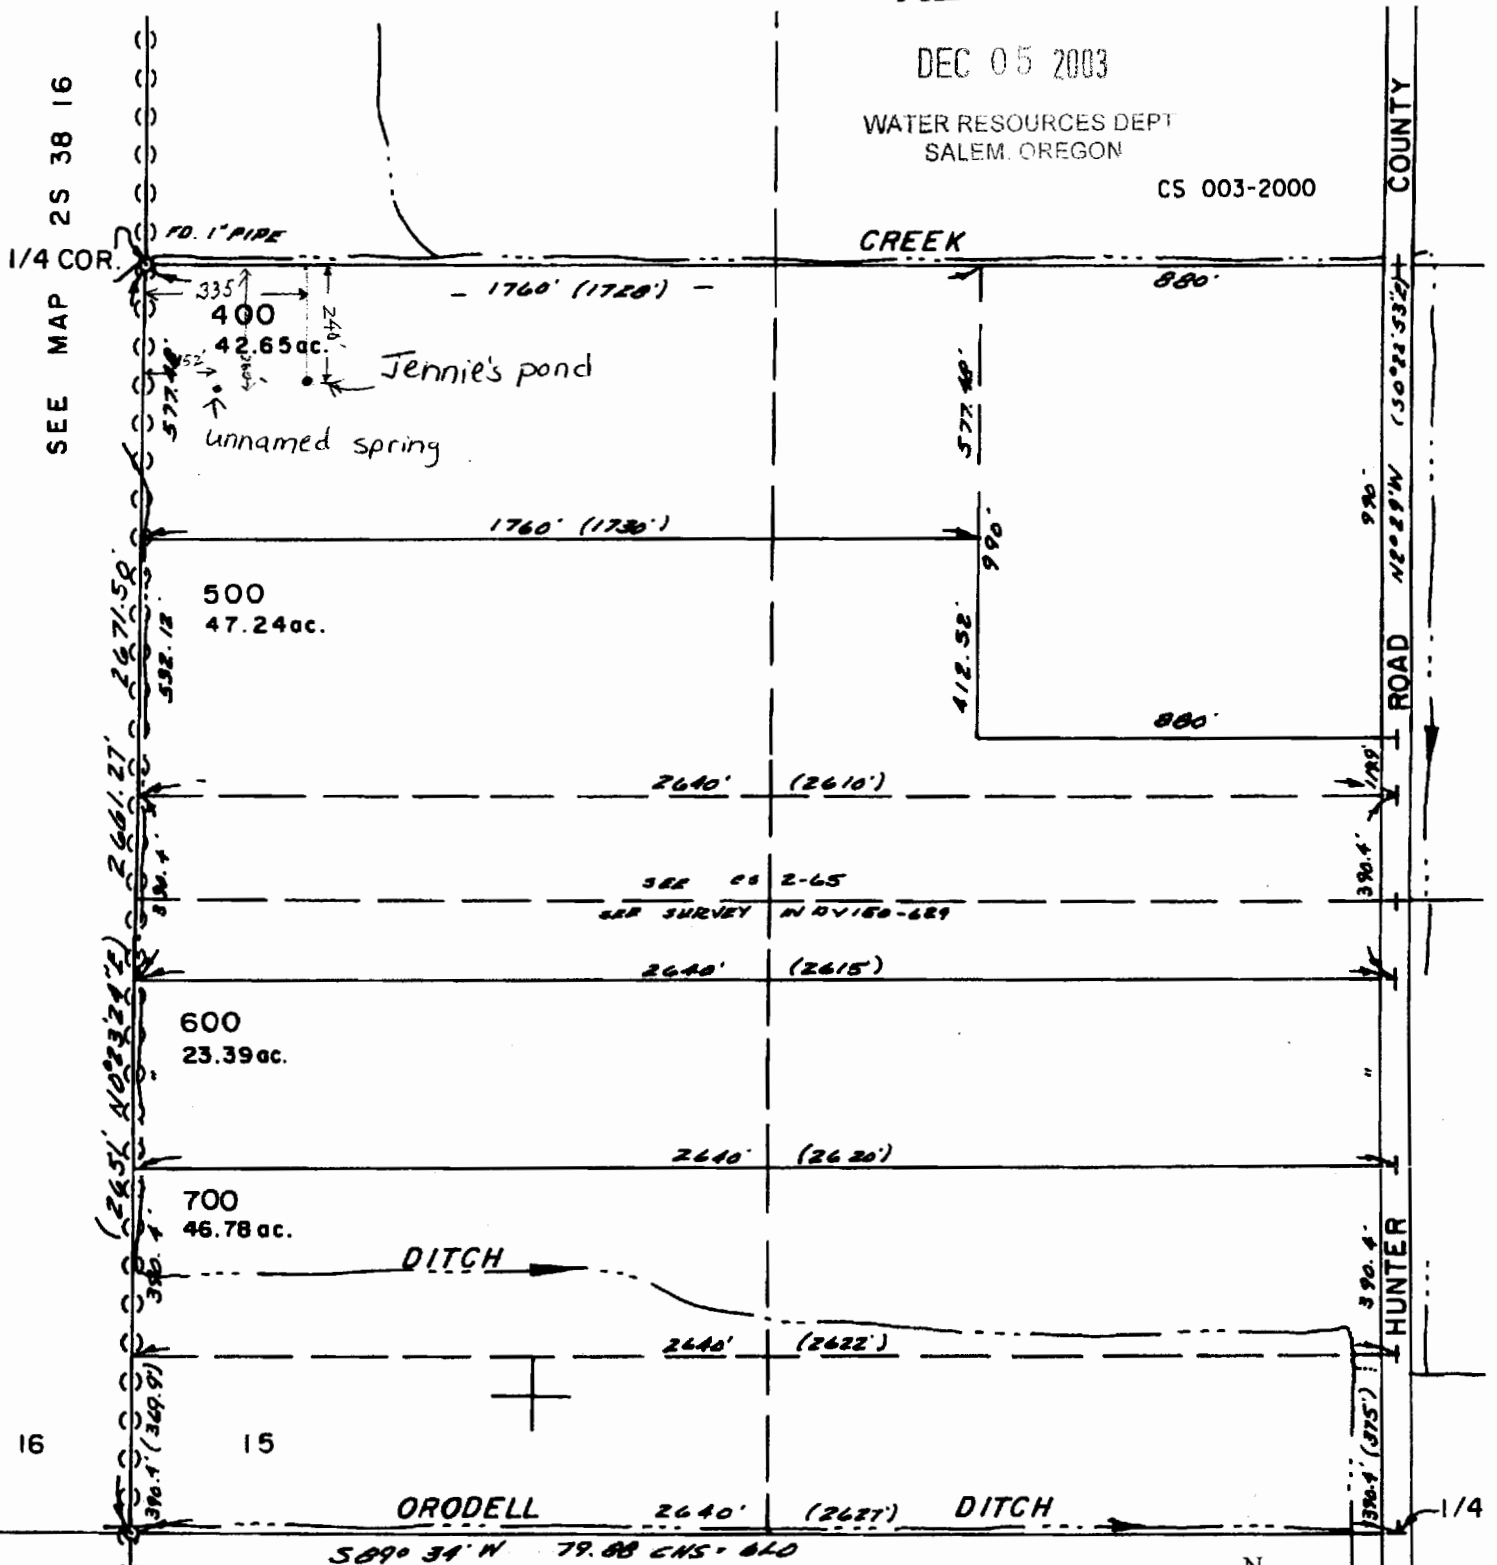

RECEIVED

APR 19 2004

WATER RESOURCES DEPT
SALEM, OREGON

Permit No. R-13899
app no R. 85887

