


T.6S.R.5W.W.M.

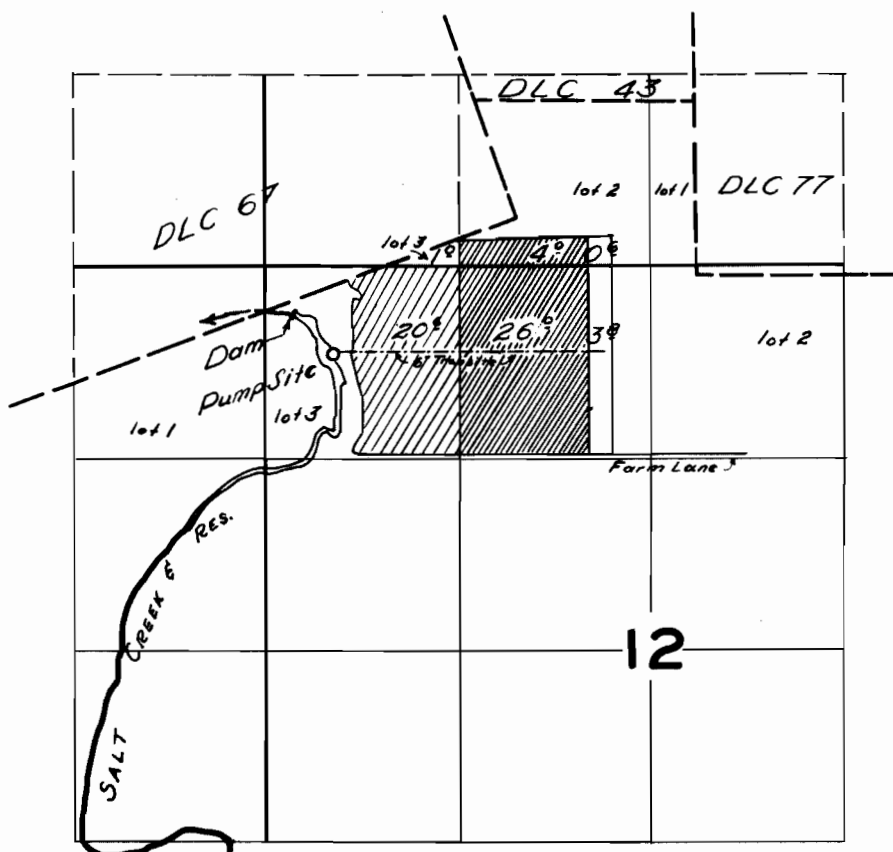

FINAL PROOF SURVEY

UNDER

Application No. 24014 & 24013 Permit No. 21570 & R-1390
28276 22232

IN NAME OF

JOE. J. DAUENHAUER

Surveyed 4 April 1957, by [Signature]

