


T 39 S, R 17 E

AK

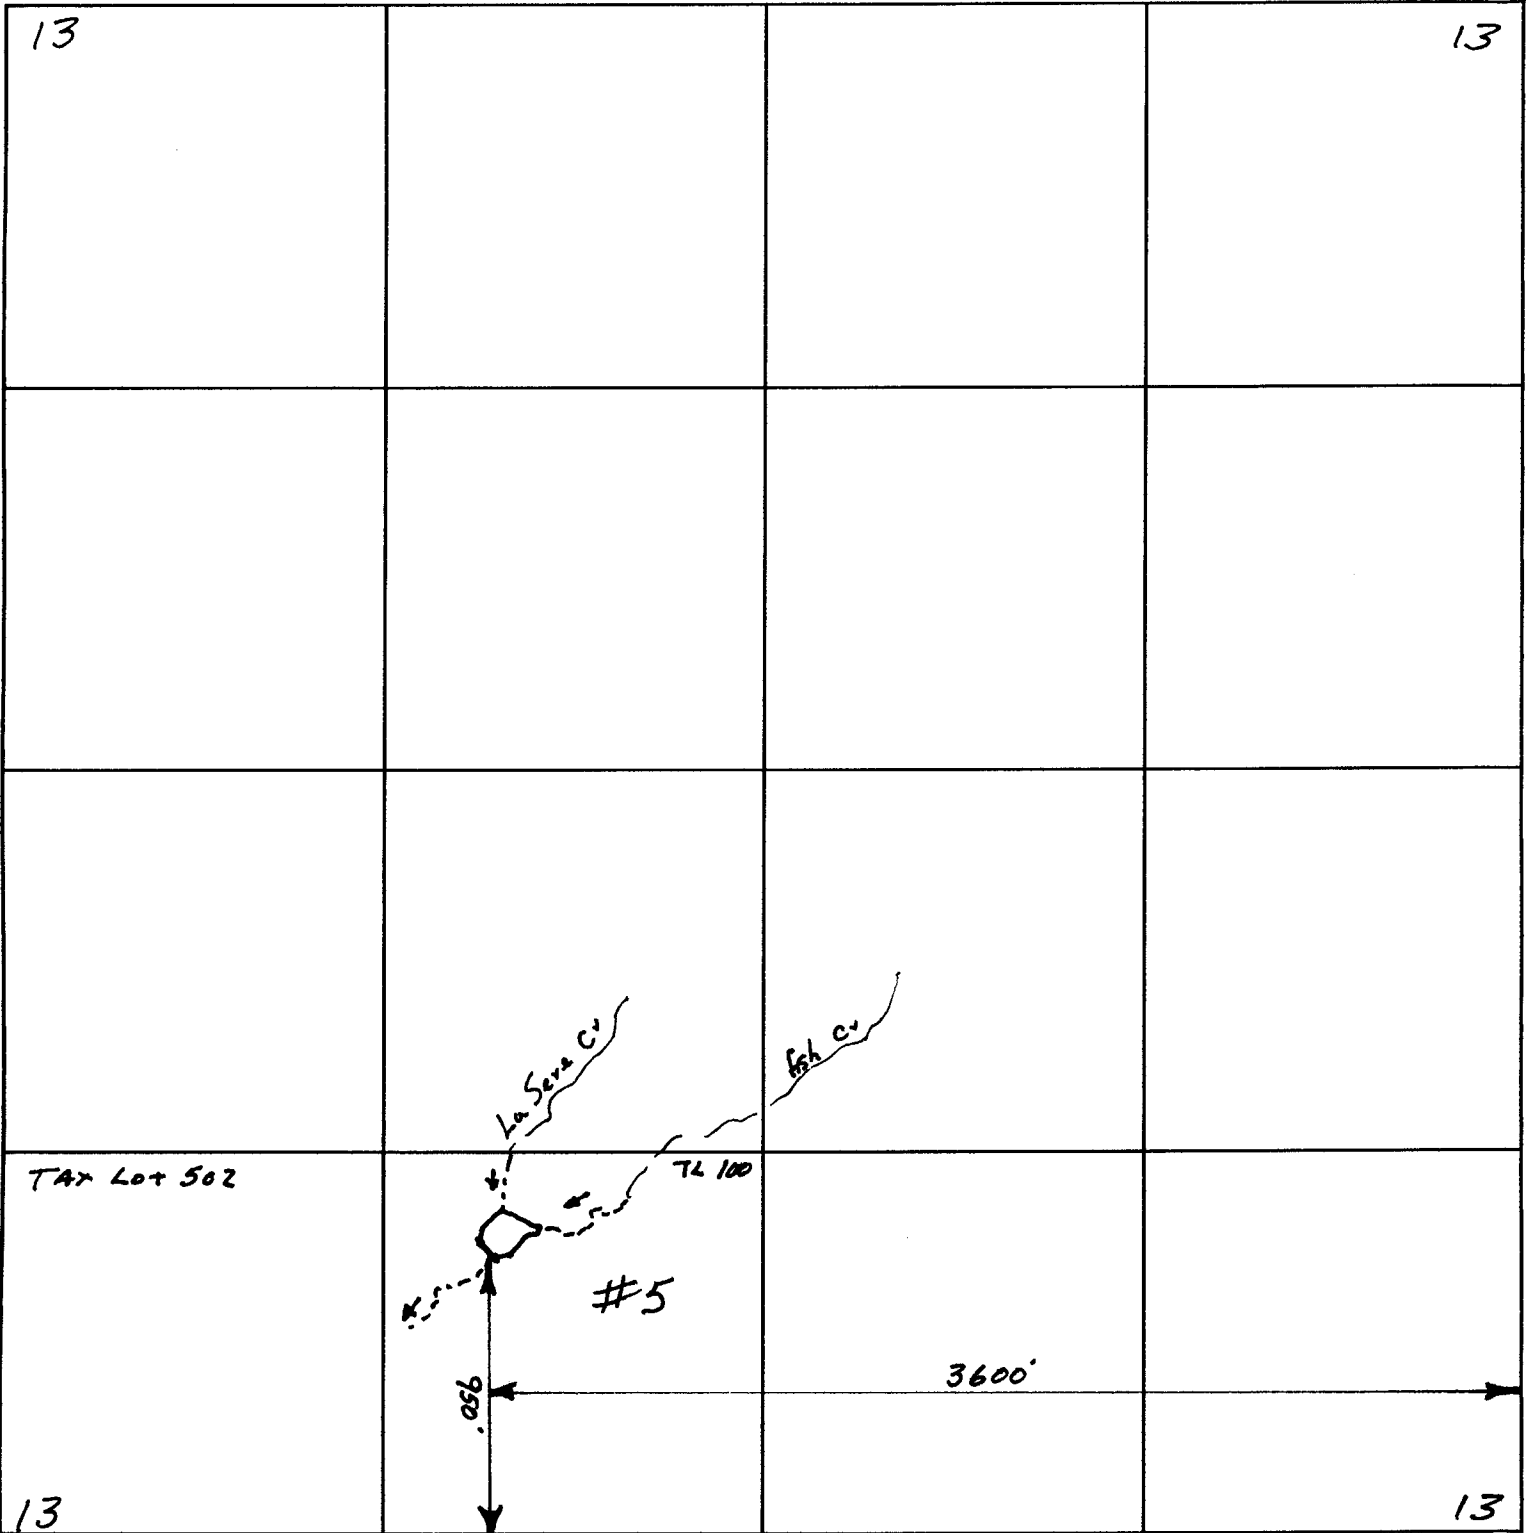

Scale 8" = 1 mile

app no R-88765
Permit NO R 13904

RECEIVED

AUG 27 2003

WATER RESOURCES DEPT.
SALEM, OREGON