


# T 39 S, R 18 E

AK

TL 1300

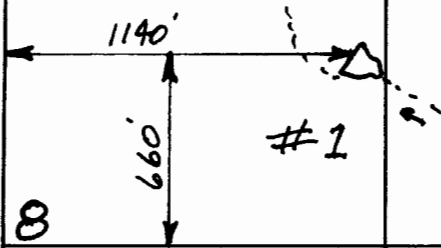

8

17

8

17

Scale 8" = 1 mile

app no R-05766  
Permit No R-13905

**RECEIVED**  
AUG 27 2003  
WATER RESOURCES DEPT.  
SALEM, OREGON