LEGEND

LINE TYPES

TAX LOT BOUNDARY — OLD PROPERTY LINE
ROAD RIGHT-OF-WAY — VACATED RIGHT-OF-WAY
RAILROAD — RAILROAD RIGHT-OF-WAY
STREAM, LAKE ETC. TAX LOT BOUNDARY — STREAM, LAKE ETC. NON-BOUNDARY
SUBDIVISION BOUNDARY — PARTITION PLAT BDY.
TAX CODE BOUNDARY — EASEMENT

SYMBOL TYPES

D.L.C.
CONTROL POINTS
SURVEY MONUMENTS
G.L.O. CORNERS
SECTION — 1/4 SEC — 1/16 SEC

NUMBERS

TAX CODE NO.

000 00 00 0

ACREAGE - ALL ACREAGES EXCLUDE ANY PORTION THAT MAY LIE WITHIN THE INDICATED PUBLIC RIGHT OF WAYS.

TICK MARKS - WHEN A TICK MARK IS INDICATED ON THE EXTENSION OF A LINE, THEN THE DIMENSION GOES TO THE TICK MARK. GENERALLY THIS IS USED WHEN DIMENSIONS GO INTO PUBLIC RIGHT OF WAYS.

ARROWS ARE USED WITH DIMENSIONS IN AREAS OF GREATER COMPLEXITY.

NOTICE: This map was created for Assessor's Office use ONLY.

Assessor "We Care" GIS Geographic Information System

SCALE 1" = 200'
or 1:2400
Plot file created: October 29, 2002

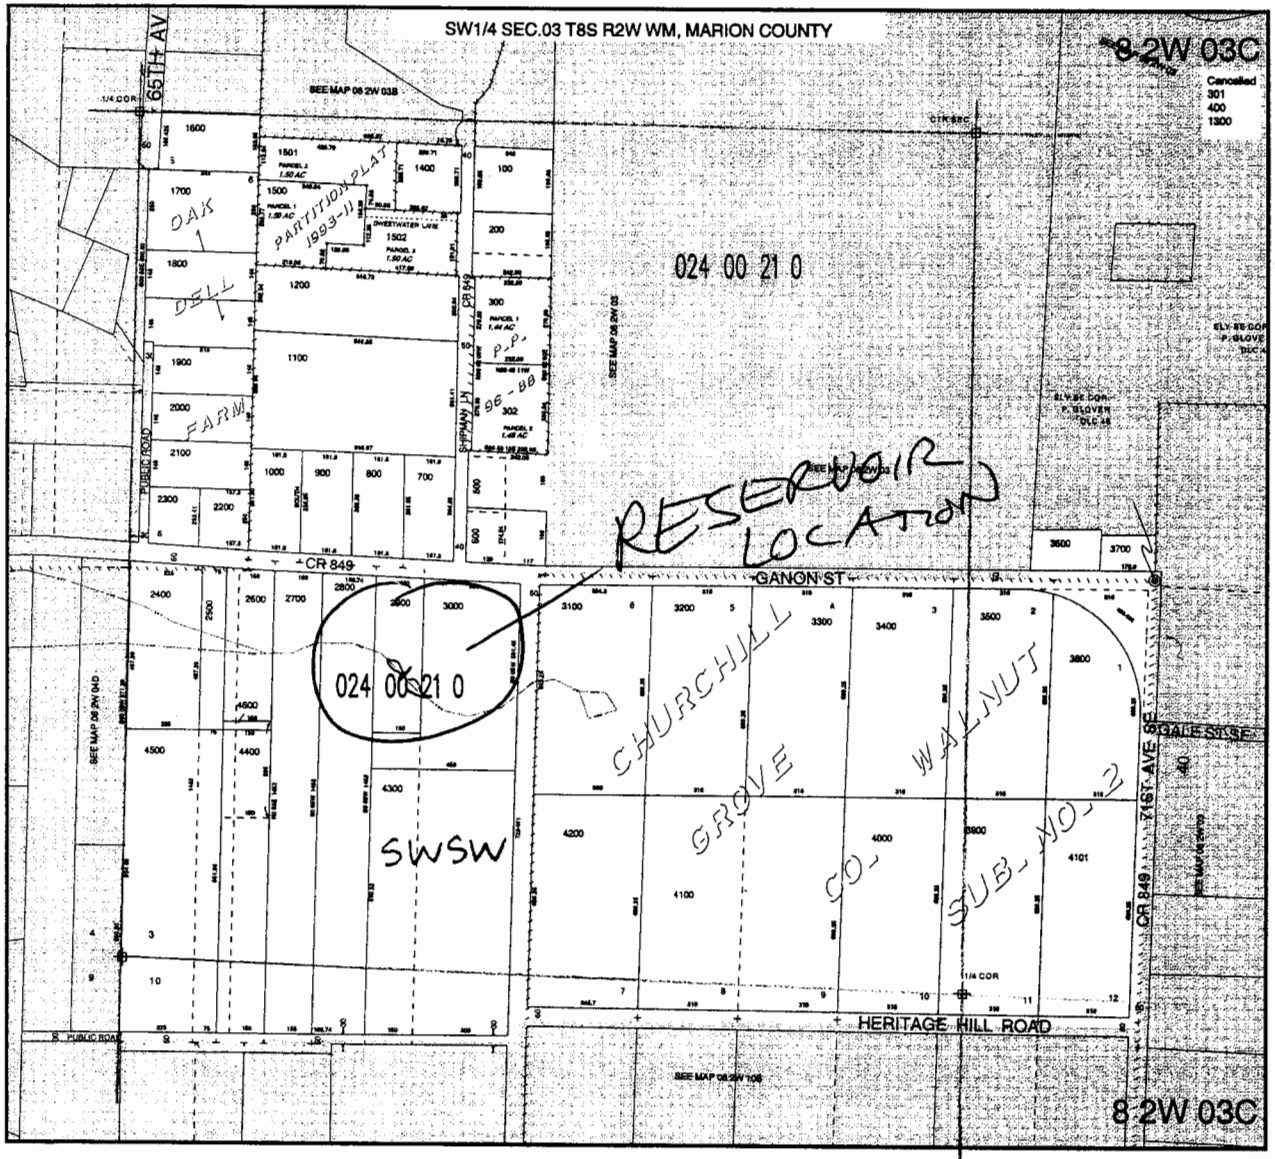

WORK COPY

RECEIVED
OCT 28 2003
WATER RESOURCES DEPT
SALEM, OR

SW1/4 SW1/4 Section 3
850 Feet E and 950 Feet N
from SW corner Section 3

Scale
1" = 600'

application R-85860
permit no R-13915