


SEC.07 T6S R1W WM, MARION

Scale 1" = 400'

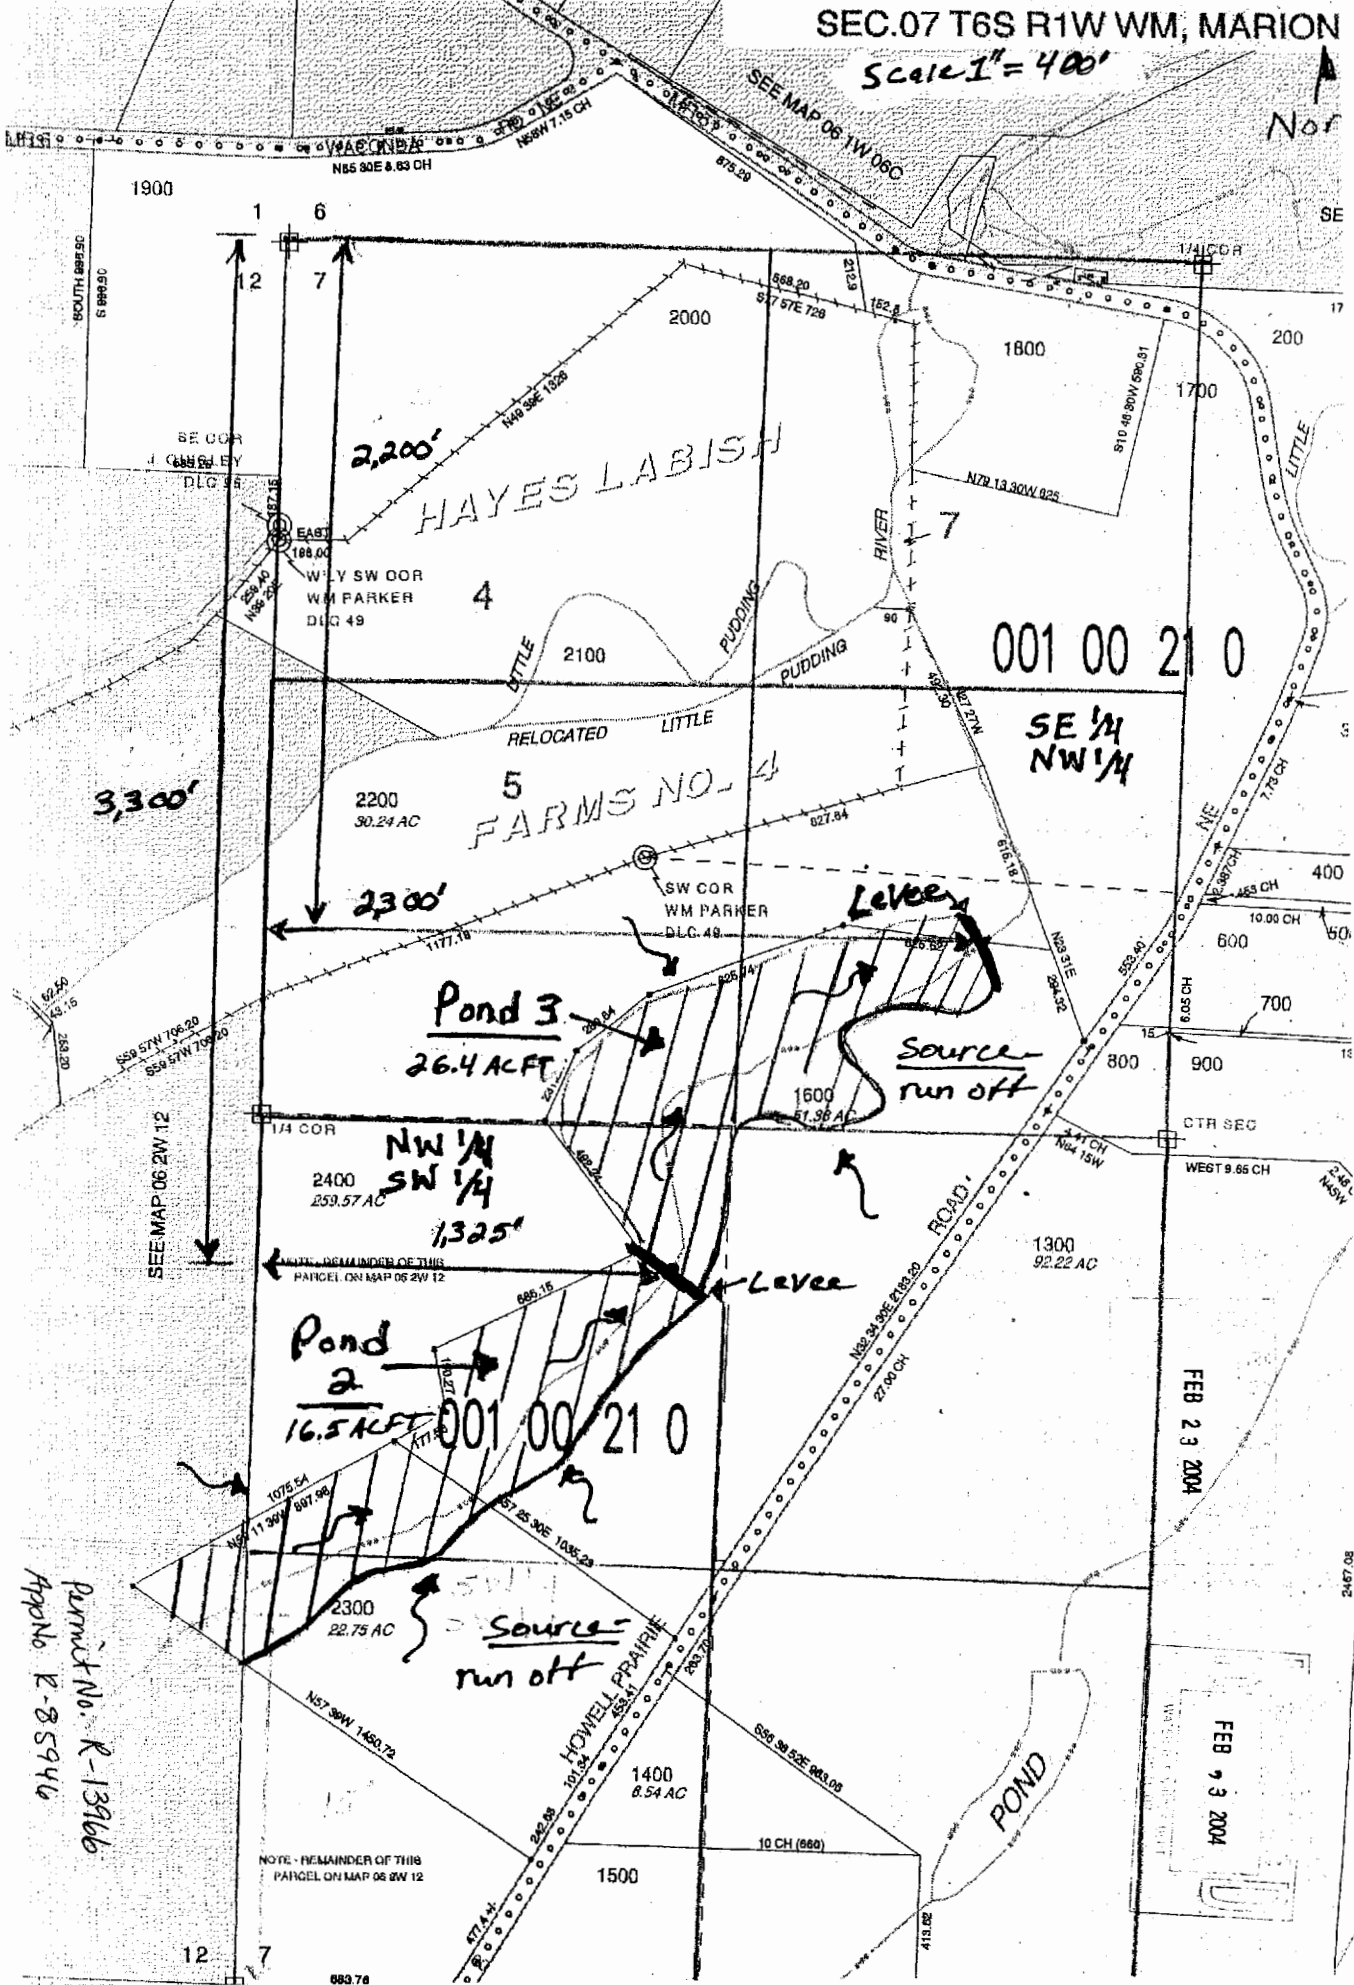

Permit No. R-13966
App No. E-85946

NOTE - REMAINDER OF THIS
PARCEL ON MAP 06 2W 12

FEB 23 2004

FEB 23 2004