


SEC.07 T6S R1W WM, MARION

Scale 1" = 400'

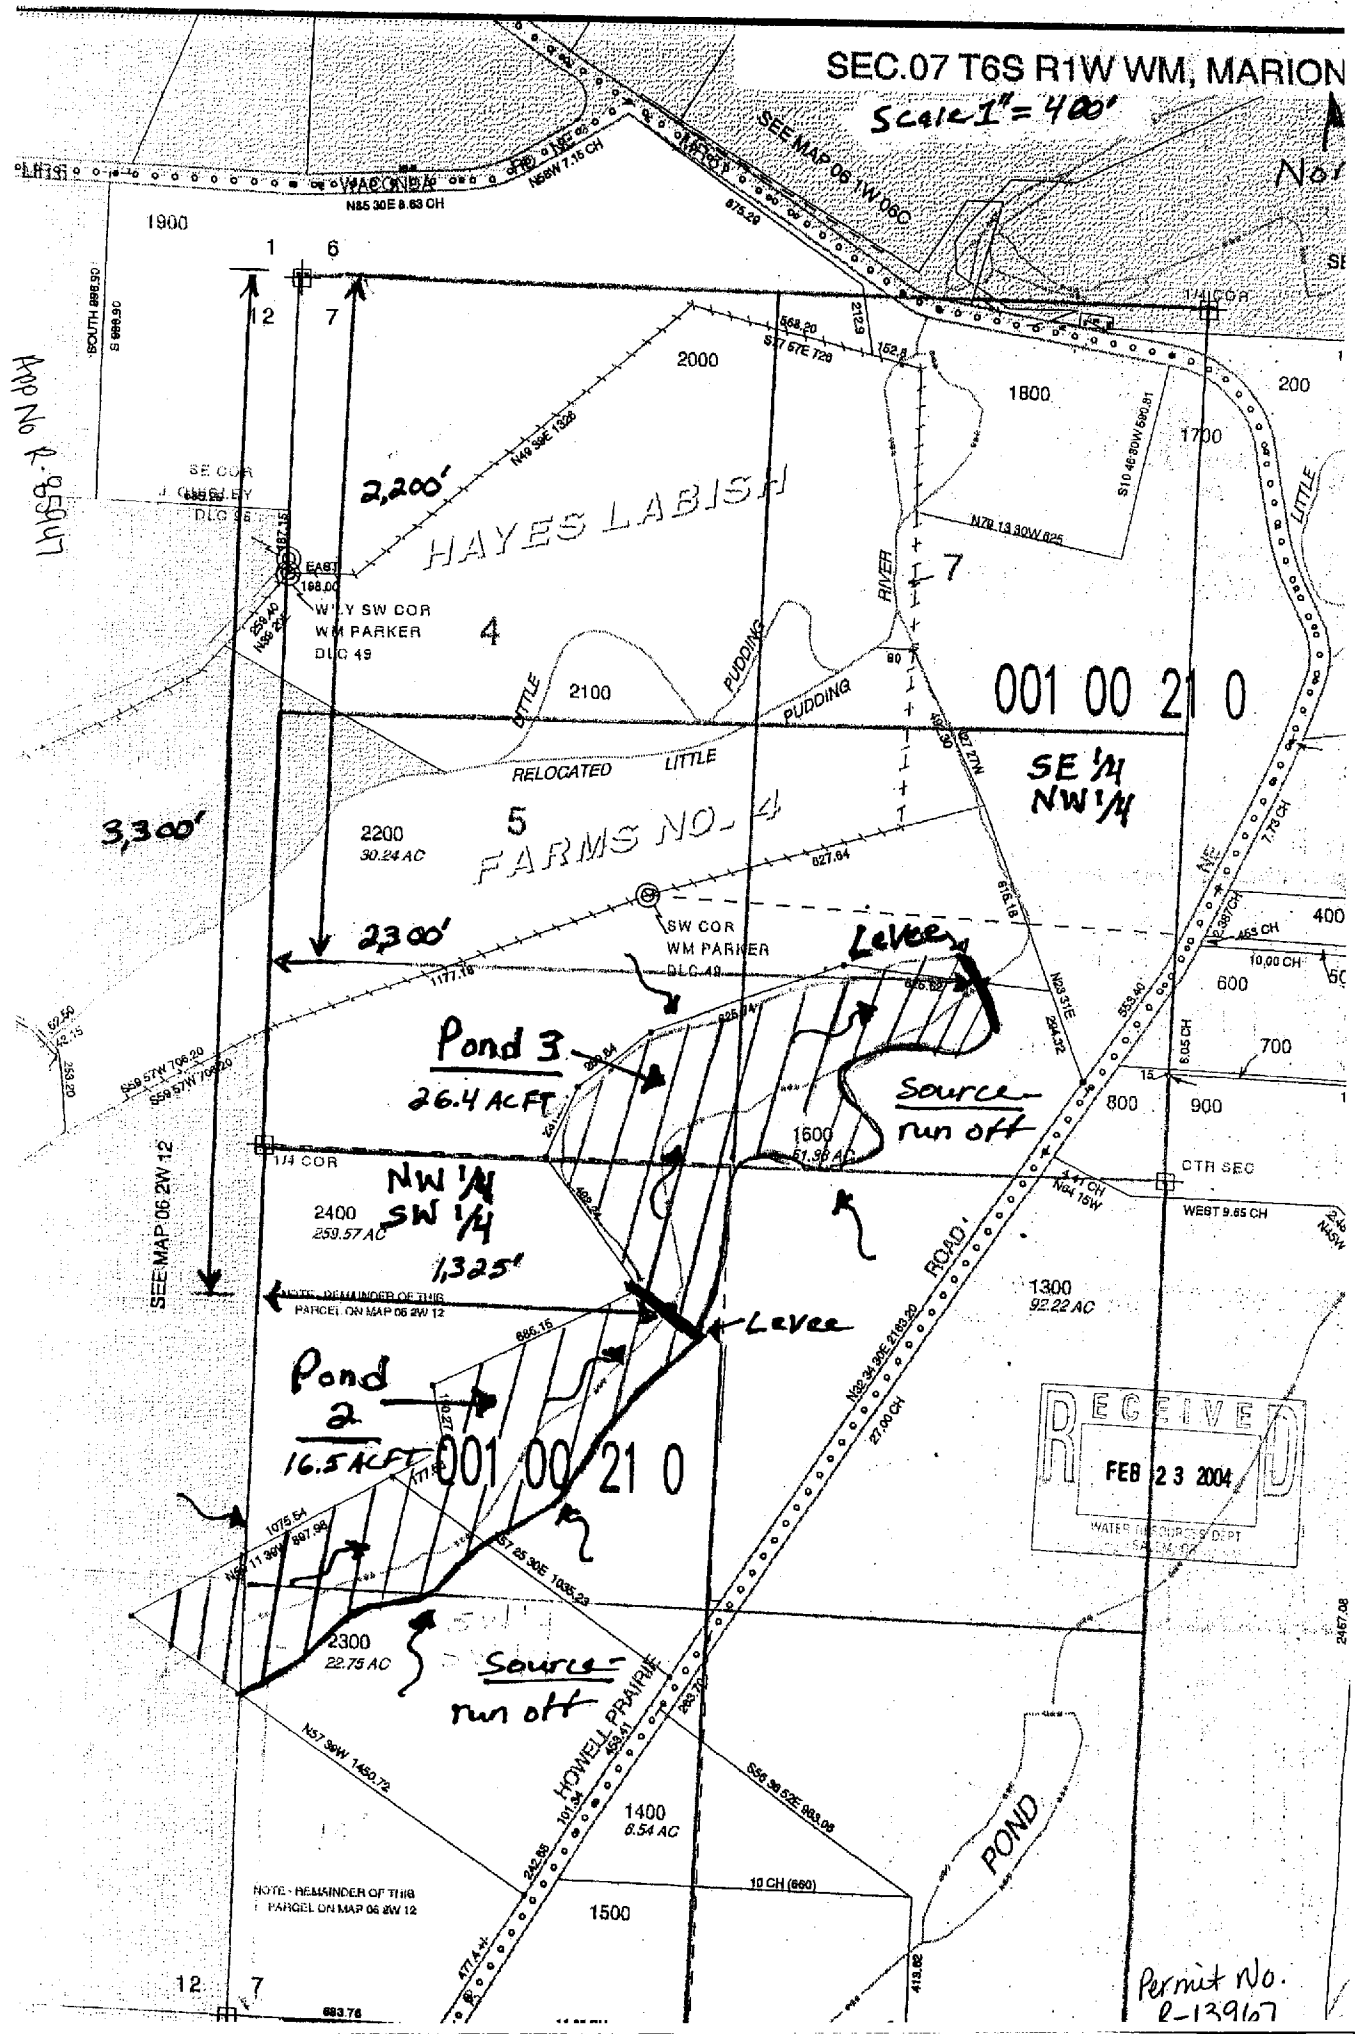


RECEIVED  
 FEB 23 2004  
 WATER RESOURCES DEPT  

