

SUBBASINS

- 5 SANTIAM
- 6 COAST RANGE
- 7 PUDDING

1978



WATER RESOURCES DEPARTMENT

MIDDLE WILLAMETTE BASIN

MAP NO. 2B.4

This map has been prepared by WRD to assist you in the review of this application. The dot in the center of the bullseye is a close approximation of the proposed diversion.

WORKING COPY




Confluence of Intermittent Channel and Hoekstre Creek

Approximate Location of Dam
1,125 feet south
965 feet east

NW Corner Section 22

NW Corner
Section 22

Drainage Basin
Boundary
300 acres +/-

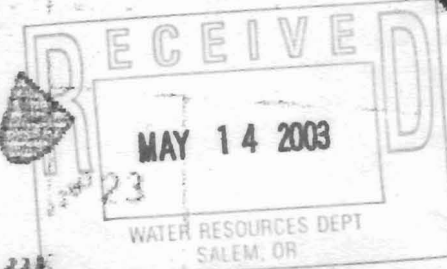

APP # R-856000
Permit # R 13979

