

MALHEUR COUNTY


1" = 1320' @ 1000'

RECEIVED

APR 07 2003

WATER RESOURCES DEPT.
SALEM, OREGON

T17s 44e 26

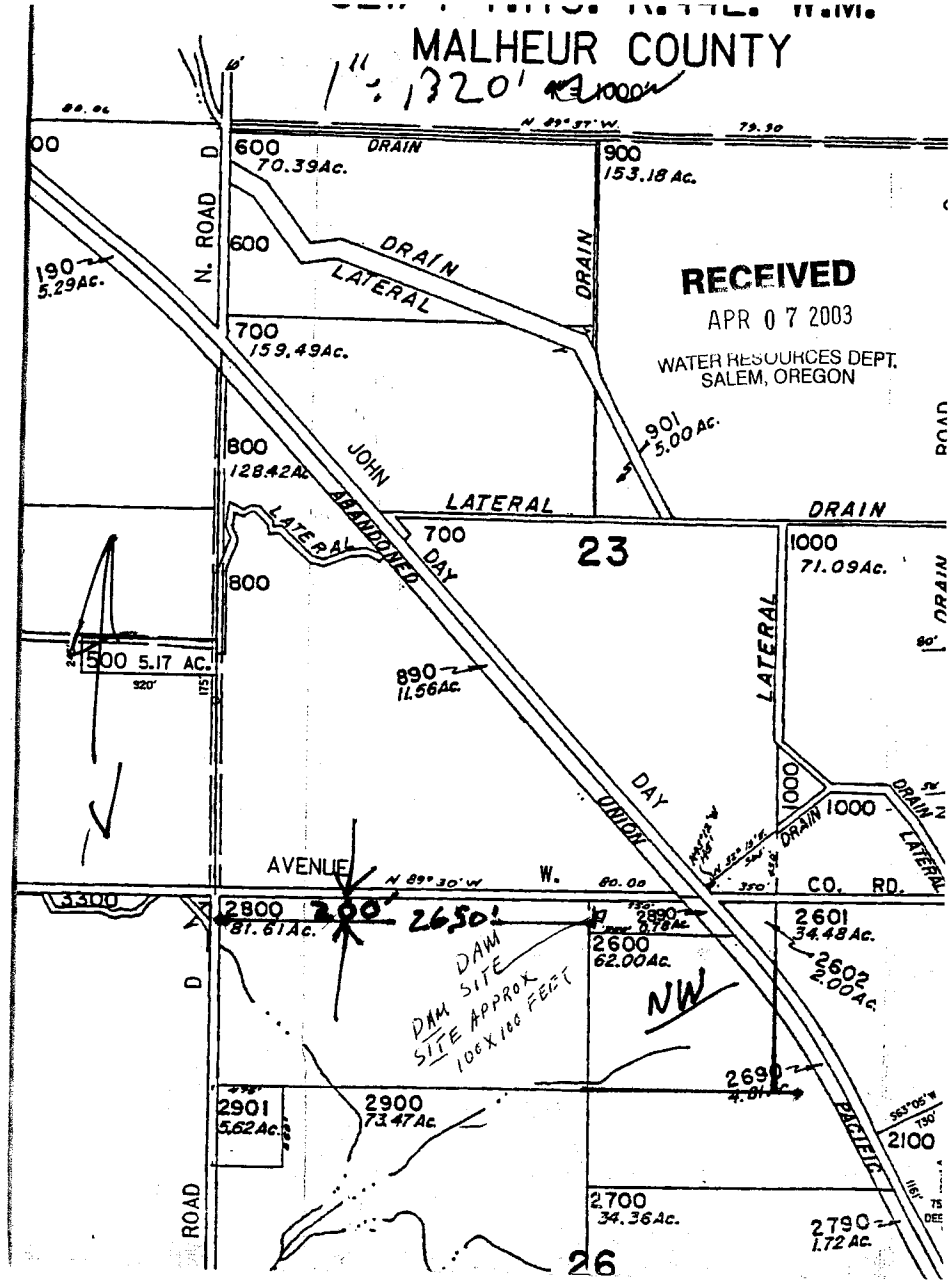

WORKING COPY

app # R-8554 &
Permit # K-14011