


Map was produced using the Polk County GIS data. The GIS data is provided by the county to support its governmental activities. The

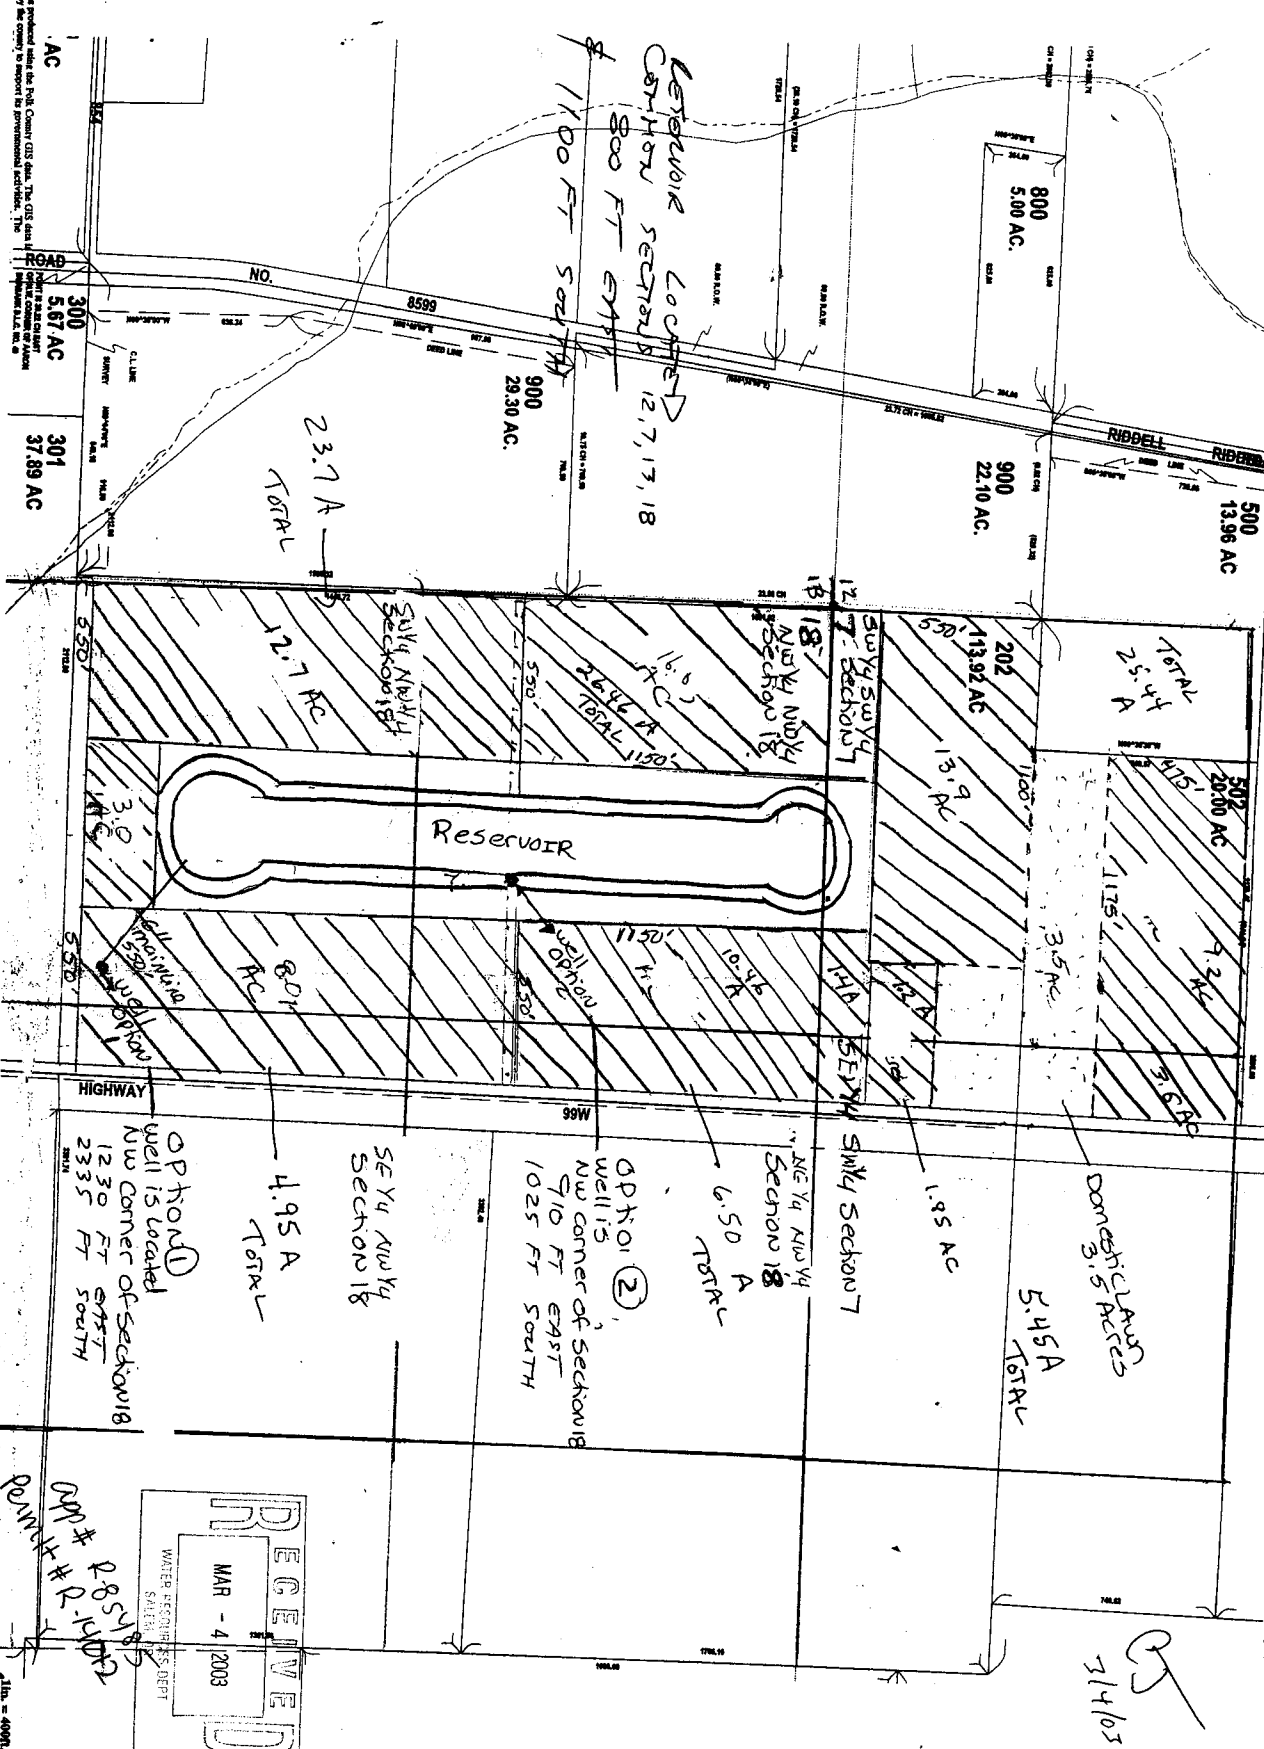

Polk County Map
 Community Development


Scale:
 1" = 4000'


RECEIVED
 MAR - 4 2003
 WATER RESOURCES DEPT.

