


T. 35 S., R. 4 W., W.M.

1/4 COR.

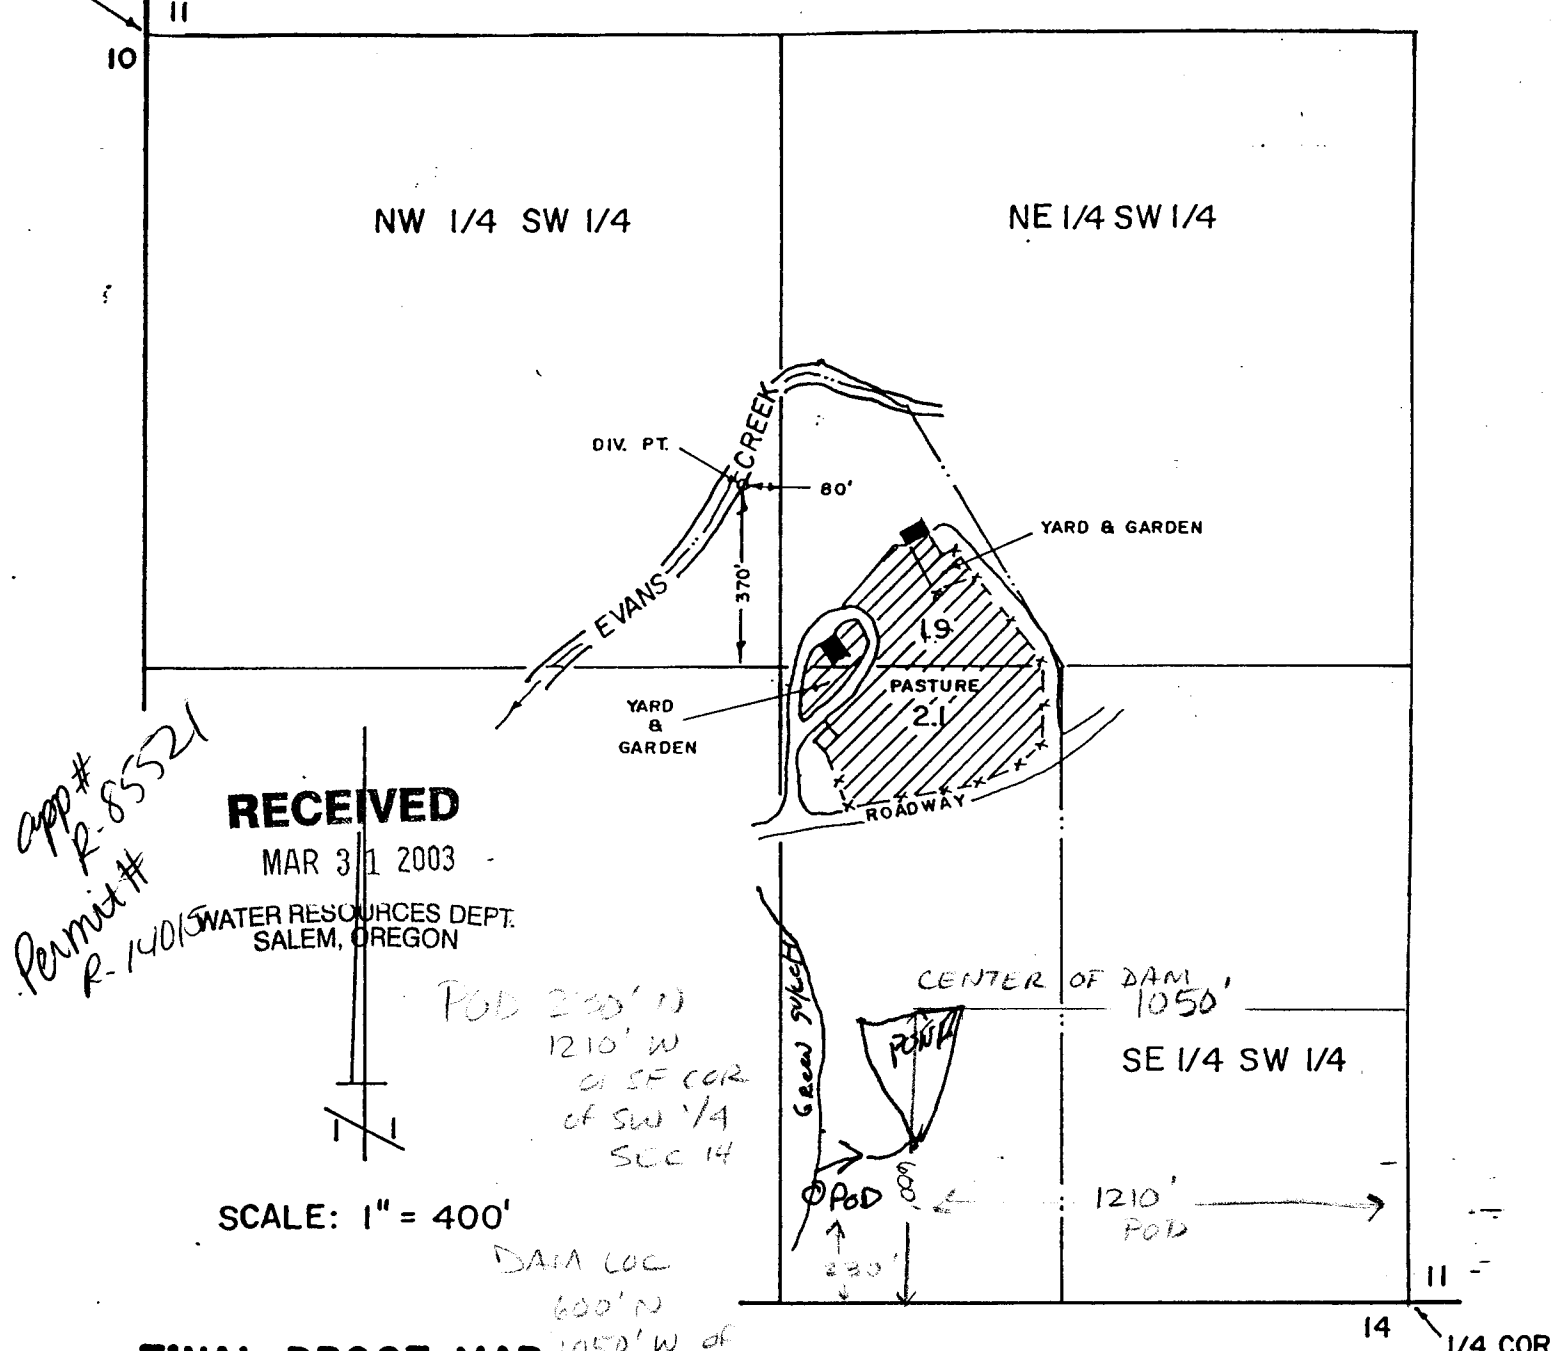

app # R-85521
 Permit # R-14015

RECEIVED

MAR 31 2003

WATER RESOURCES DEPT.
 SALEM, OREGON

POB 230' N
 1210' W
 of SE COR.
 of SW 1/4
 SEC 14

SCALE: 1" = 400'


DAM LOC
 600' N

FINAL PROOF MAP

TRANSFER No. T-6280

IN THE NAME OF
LARRY P. MENTEER

NOTE: THIS MAP HAS BEEN PREPARED FOR WATER RIGHT PURPOSES ONLY, NOT FOR PROPERTY BOUNDARY LOCATIONS

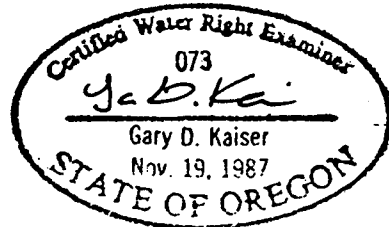

MAP PREPARED SEPTEMBER 17, 1992 BY GARY D. KAISER