


SEC. 07 T6S R1W WM, MARION

Scale 1" = 400'

North

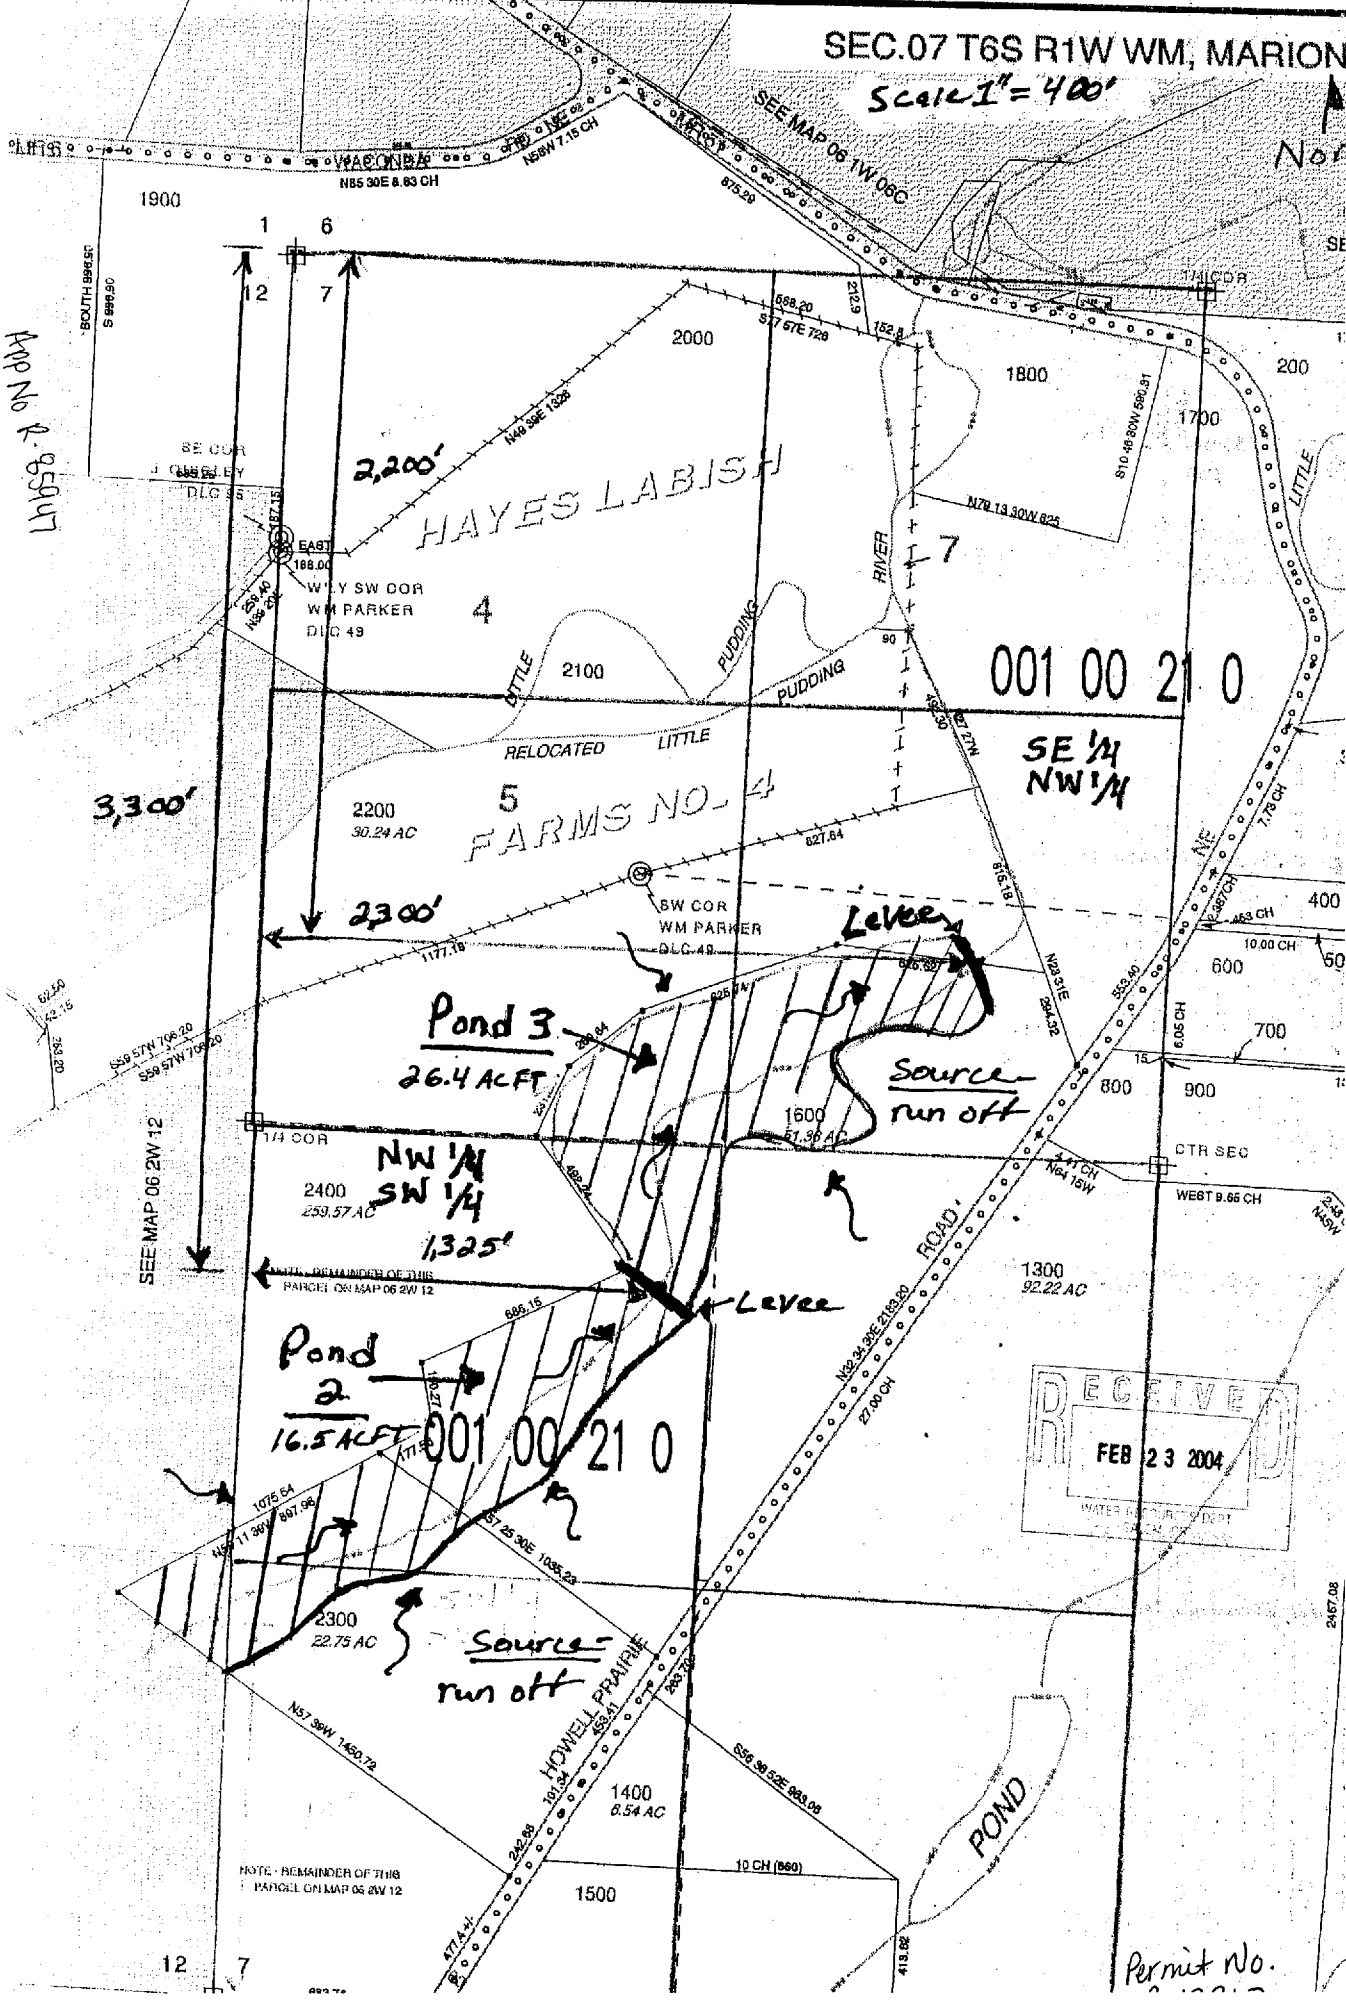


RECEIVED
 FEB 23 2004
 WATER RESOURCES DEPT.

Permit No.

NOTE - REMAINDER OF THIS PARCEL ON MAP 06 2V 12

12 7