


Amended  
5/21/04  
DRG

# TOWNSHIP 36 SOUTH, RANGE 21 EAST, WM

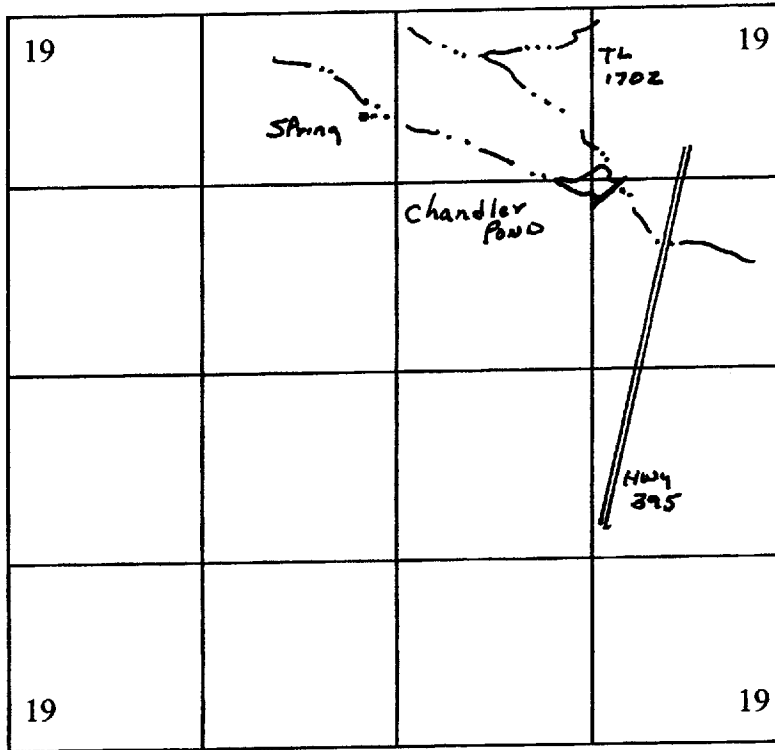

Dam Located  
1340' S of 1250' E  
From the WEC corner  
SEC 19.

DRG  
5/26/04

Scale - 1" = 1320'

**RECEIVED**  
MAY 26 2004  
WATER RESOURCES DEPT  
SALEM, OREGON

app # R-85993  
Permit # R-14033