


RILKER WATER STORAGE APPLICATION (SAGE BASIN POND)

SECTION 11

TAX LOT - 3506
LEGAL - NE 1/4 SW 1/4 6538E
Section 14

SECTION 14

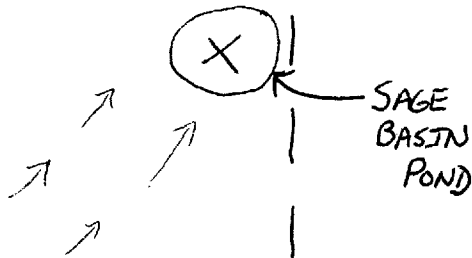

RECEIVED

MAY 12 2004

WATER RESOURCES DEPT
SALEM, OREGON

SECTION 23

POND LOCATION: 800' South
50' West from the CENTER OF SECTION 14

app no. R-86002

Permit no. R14040