


Ricker Water Storage Application (Pine Basin Pond)

Section 11

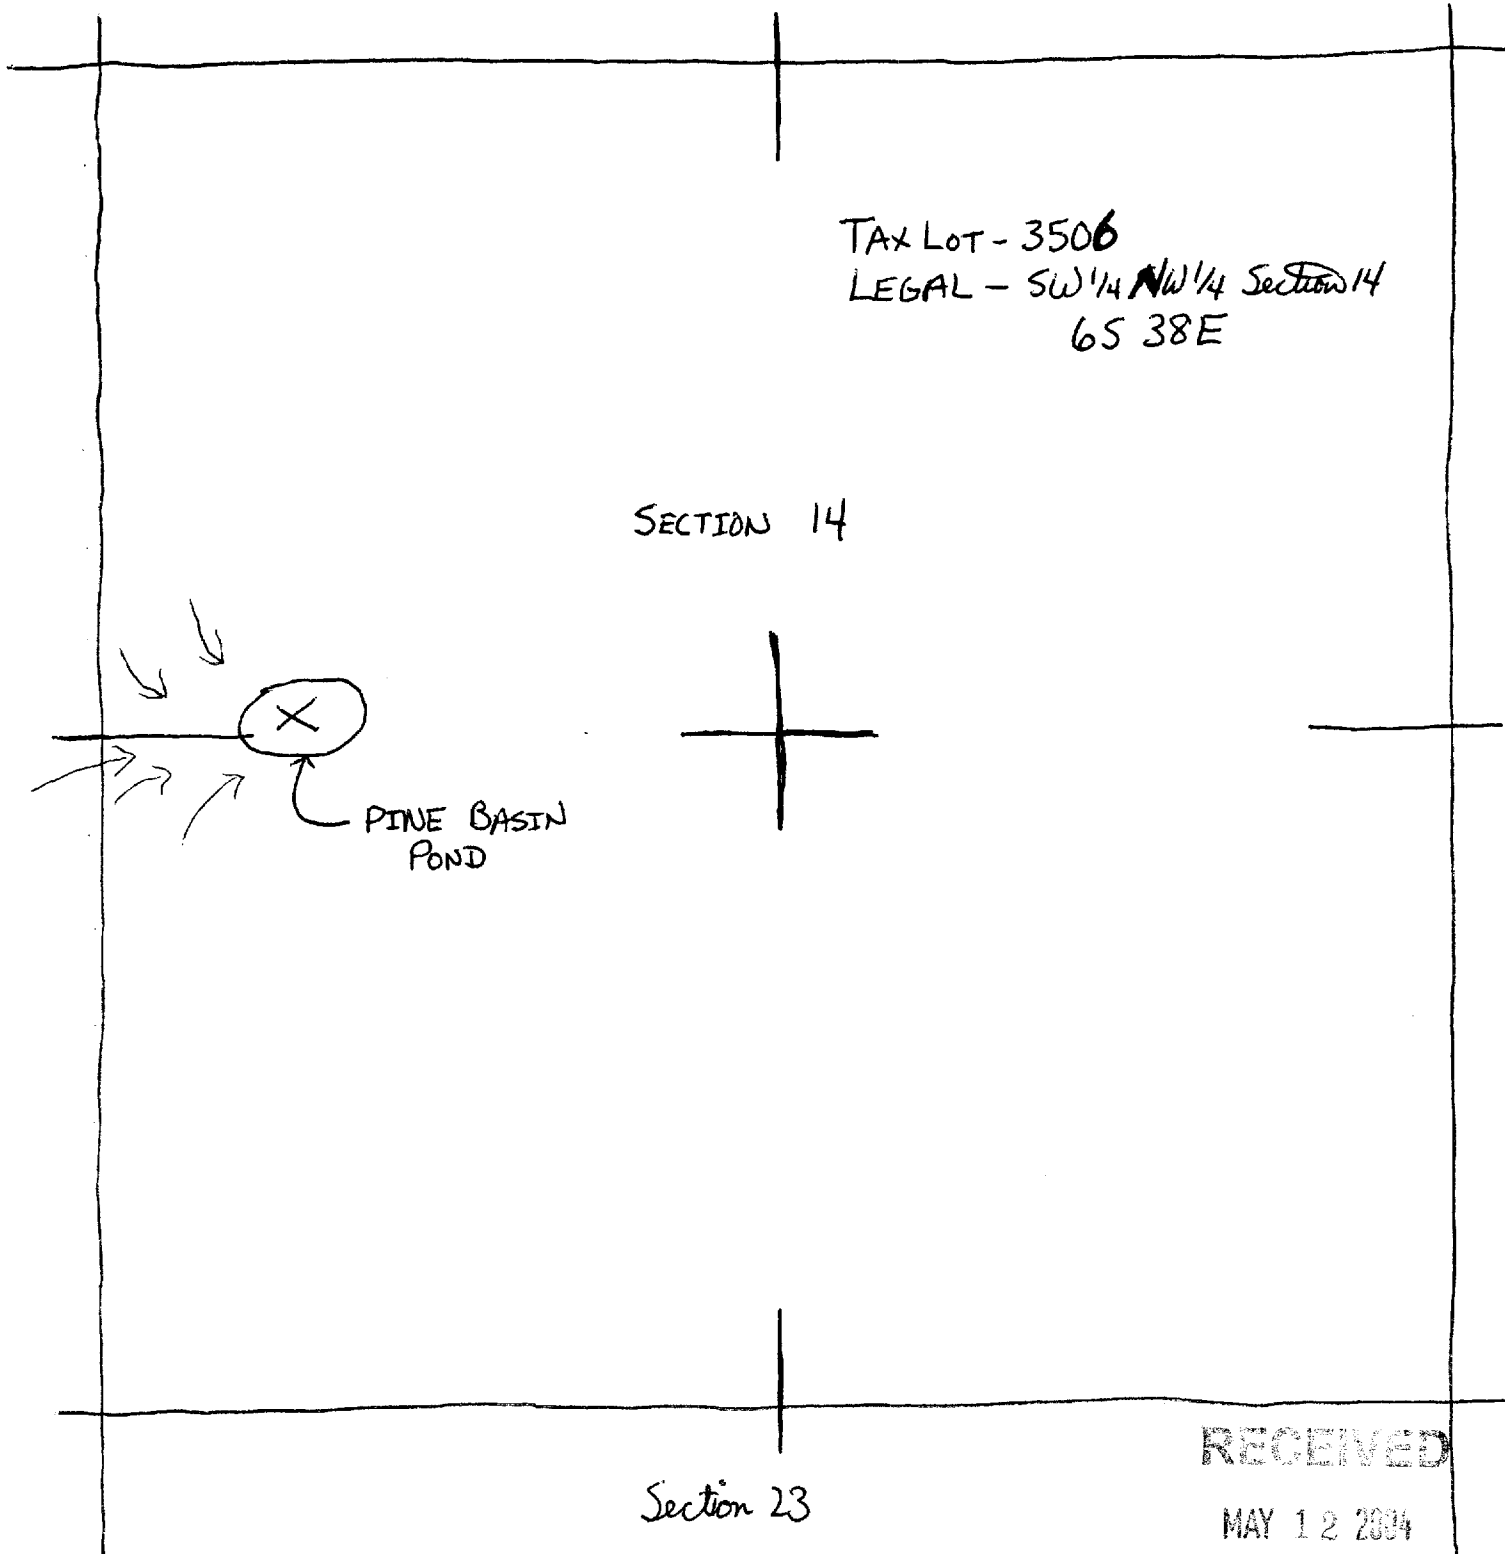

RECEIVED

MAY 12 2004

WATER RESOURCES DEPT.
SALEM, OREGON

POND LOCATION - 500' EAST

50' N of the SW Corner of the NW 1/4 of
Section 14

app no. R-86004

Permit no. R-14042