


Permit no. R-1404  
App no. R86007

WATER RESOURCES DEPT  
SALEM, OREGON

MAR 29 2004

RECEIVED

SUBJECT  
PROPERTY  
ON  
CALKINS LANE  
NEWBERG

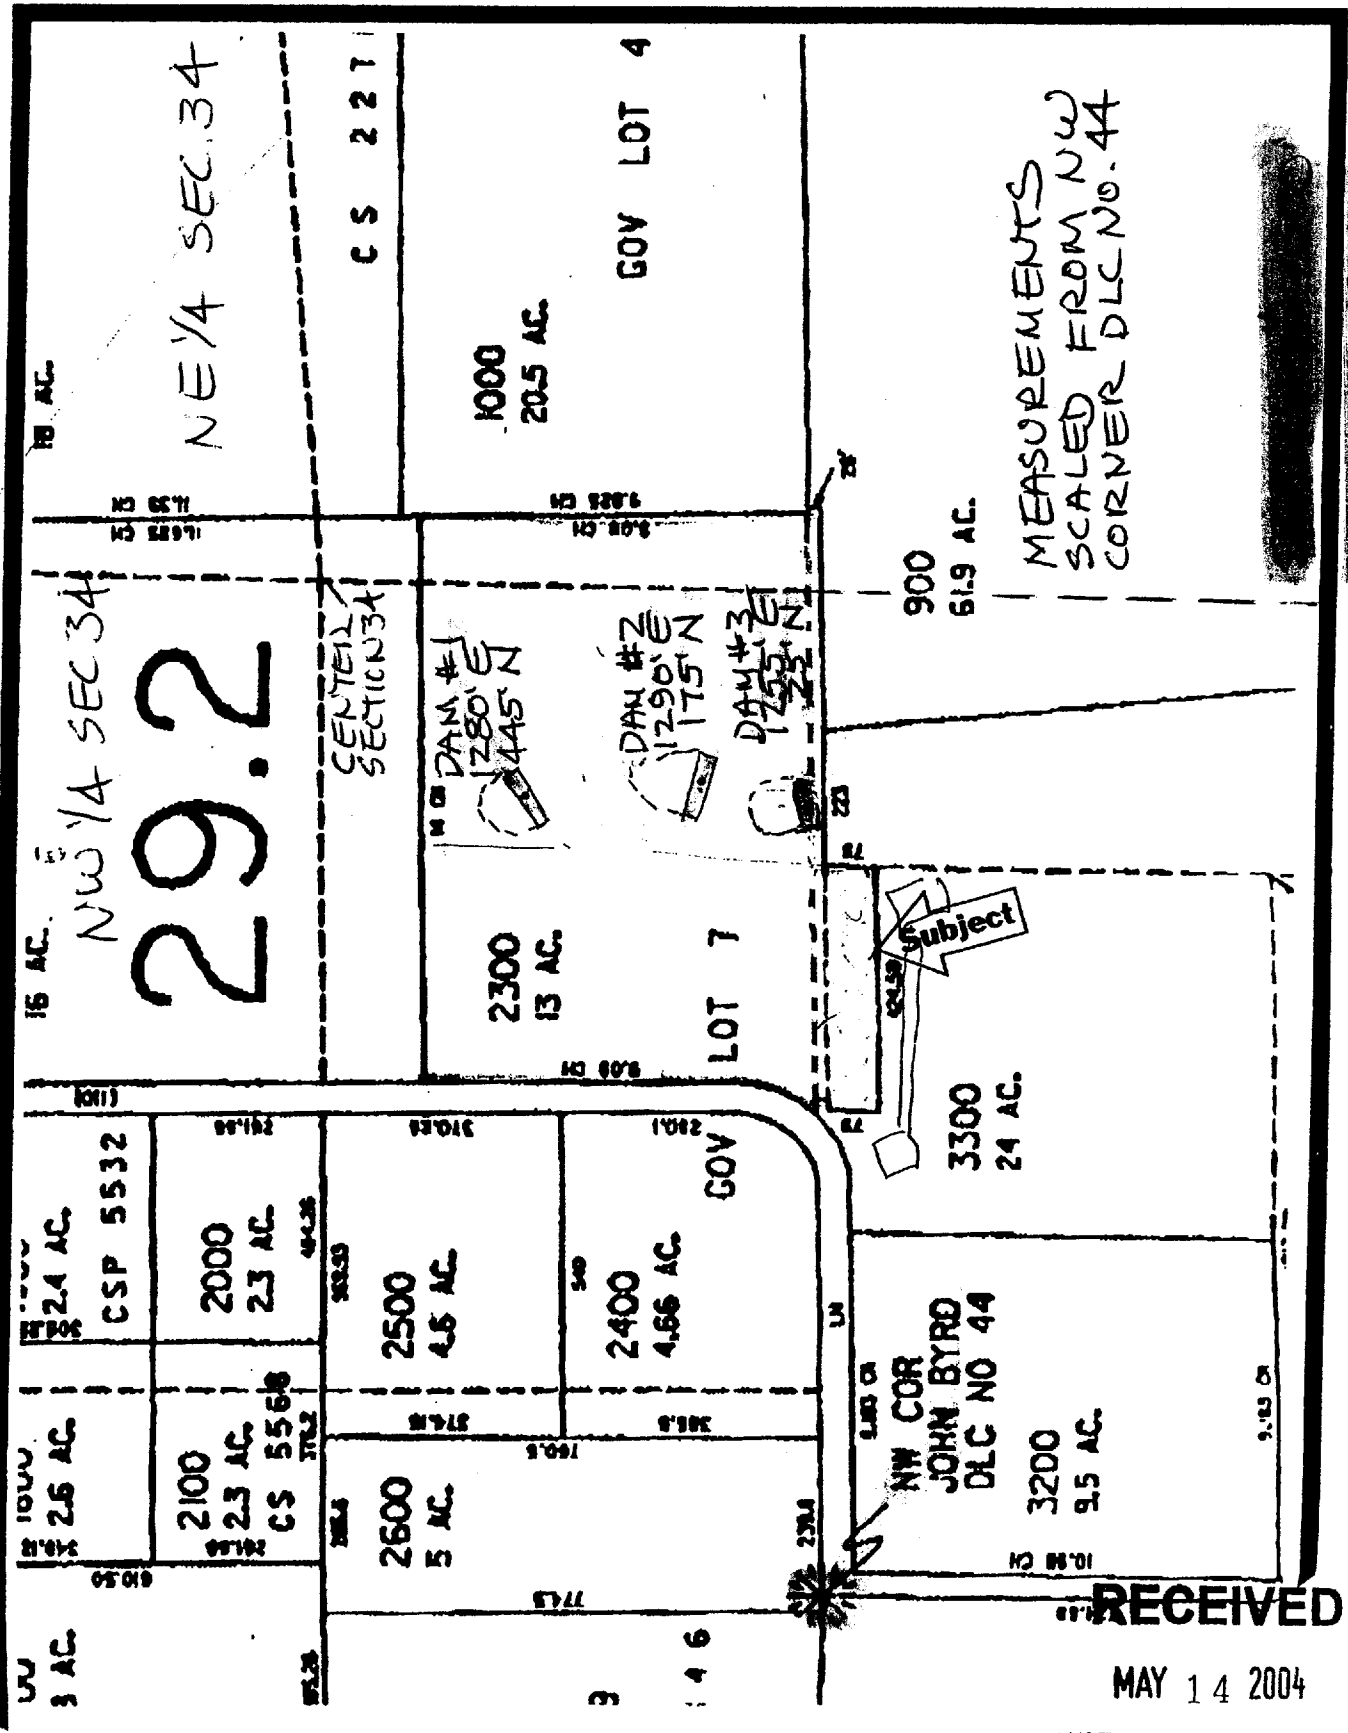

SECTION 34  
NE 1/4 of SECTION 34

RECEIVED

MAY 14 2004

WATER RESOURCES DEPT  
SALEM, OREGON