


Daryl Fisher
 7808 Amity Rd
 Amity One 97101
 (503) 8352072
 Yamhill County

North




Scale 1" = 200'

Tax Lot
 5422.501

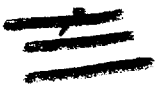


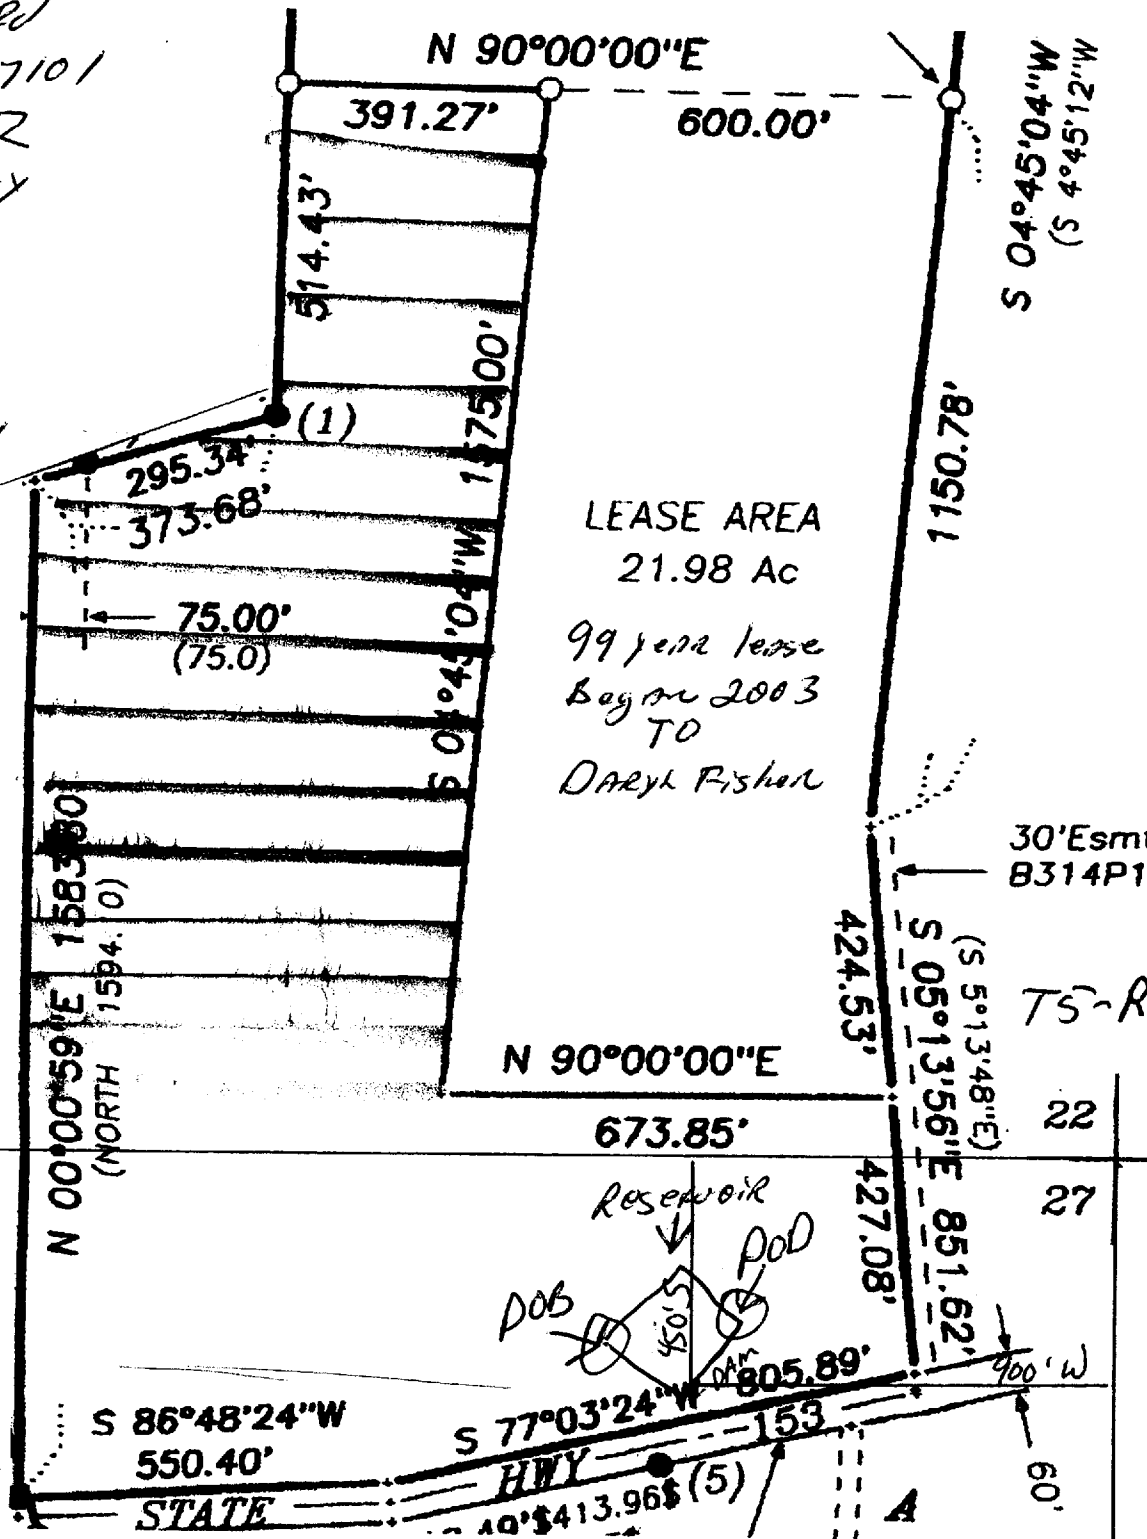

450' S & 900' W
 from NE Corner, Section 27

MAY 28 2004

WATER RESOURCES DEPT
 SALEM, OREGON

map no. R-86015

Reservoir #2
 Water Rights Application Map Permit no. R140