

Quail Meadow FARMS Inc

POB 114

LANGLOIS Pt 97450

Township 30S

RANGE 15W

Section 11

RECEIVED

DEC 23 1996

WATER RESOURCES DEPT.
SALEM, OREGON

Application No. R-81900
Permit No.

Scale 1" = 330'

⊕ 1/4 Sec Corner

• 1/16 Sec Corner

RECEIVED


JAN 23 1997

WATER RESOURCES DEPT.
SALEM, OREGON

PIPE LINE To Croftlake Road

PIPE LINE B/w To County
WAYNE Foster Road
Owner

2360 FT

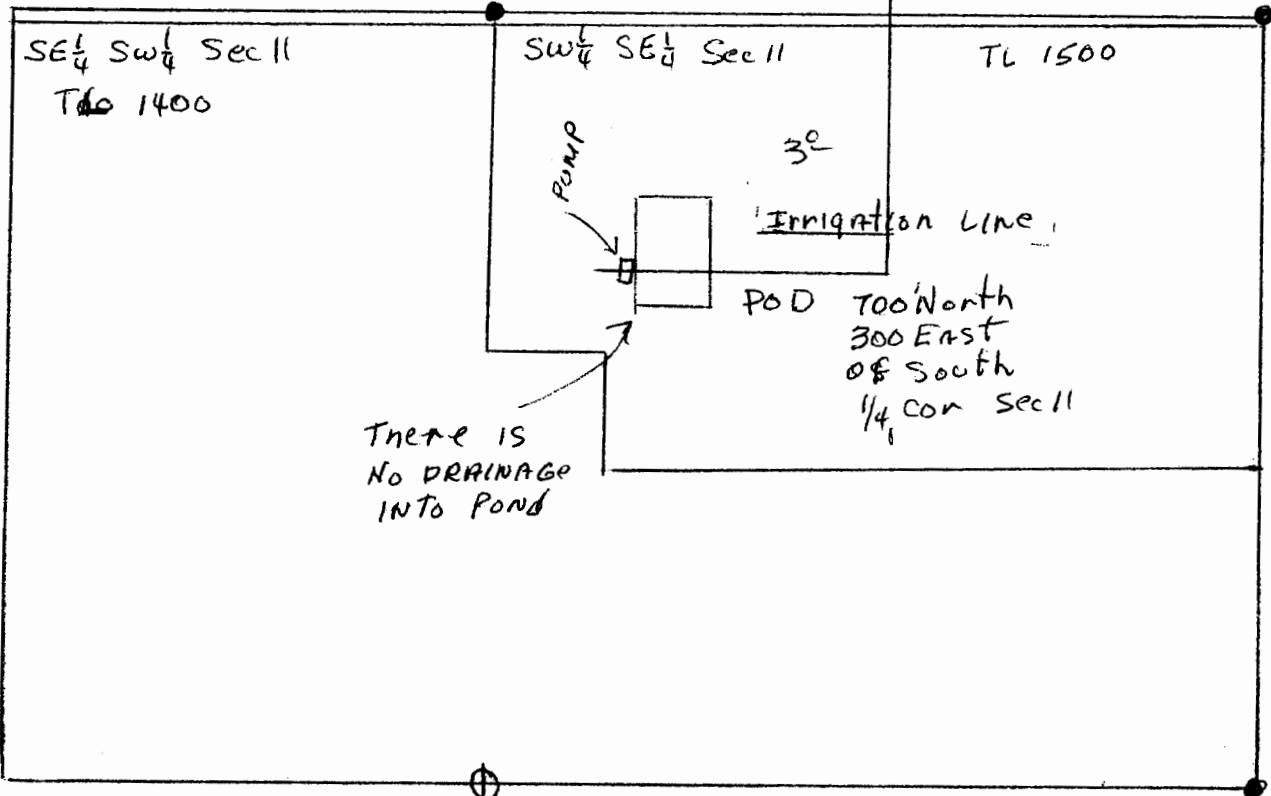

There is
NO DRAINAGE
INTO POND

POD 700' North
300' East
0' South
1/4 cor Sec 11

Irrigation Line

PUMP

SE 1/4 SW 1/4 Sec 11
TL 1400

SW 1/4 SE 1/4 Sec 11

TL 1500

N

⊕

QUAIL MEADOW FARMS

SCALE 1"=200

PUMP #1 5 HP Electric R81900

AUG 16, 2003

PUMP #2 25 HP Electric R81899

SW 1/4 of SE 1/4, SEC 11 T 30S R 15 W 16 Ac Bogs

Corners Found @

Bog # 1, 2, 3, 4

Tax Lot Line

RECEIVED
 AUG 20 2003
 WATER RESOURCES DEP.
 SALEM, OREGON

