

Polk County Map

Community Development


- Roads**
- OTHER
 - CO-GRAVL
 - STATEHWY
 - CO-PAVED
- Section**
- 1
 - 5
- Taxlot**
- Taxlot Arrows
 - Taxlot Boundary


The Dams form the North Edge of Both Ponds


RECEIVED

JUL 30 2004

WATER RESOURCES DEPT
SALEM, OREGON

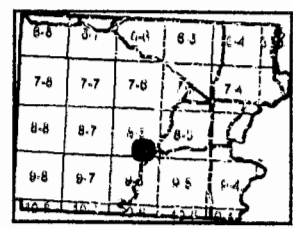

N 4/14/2004 

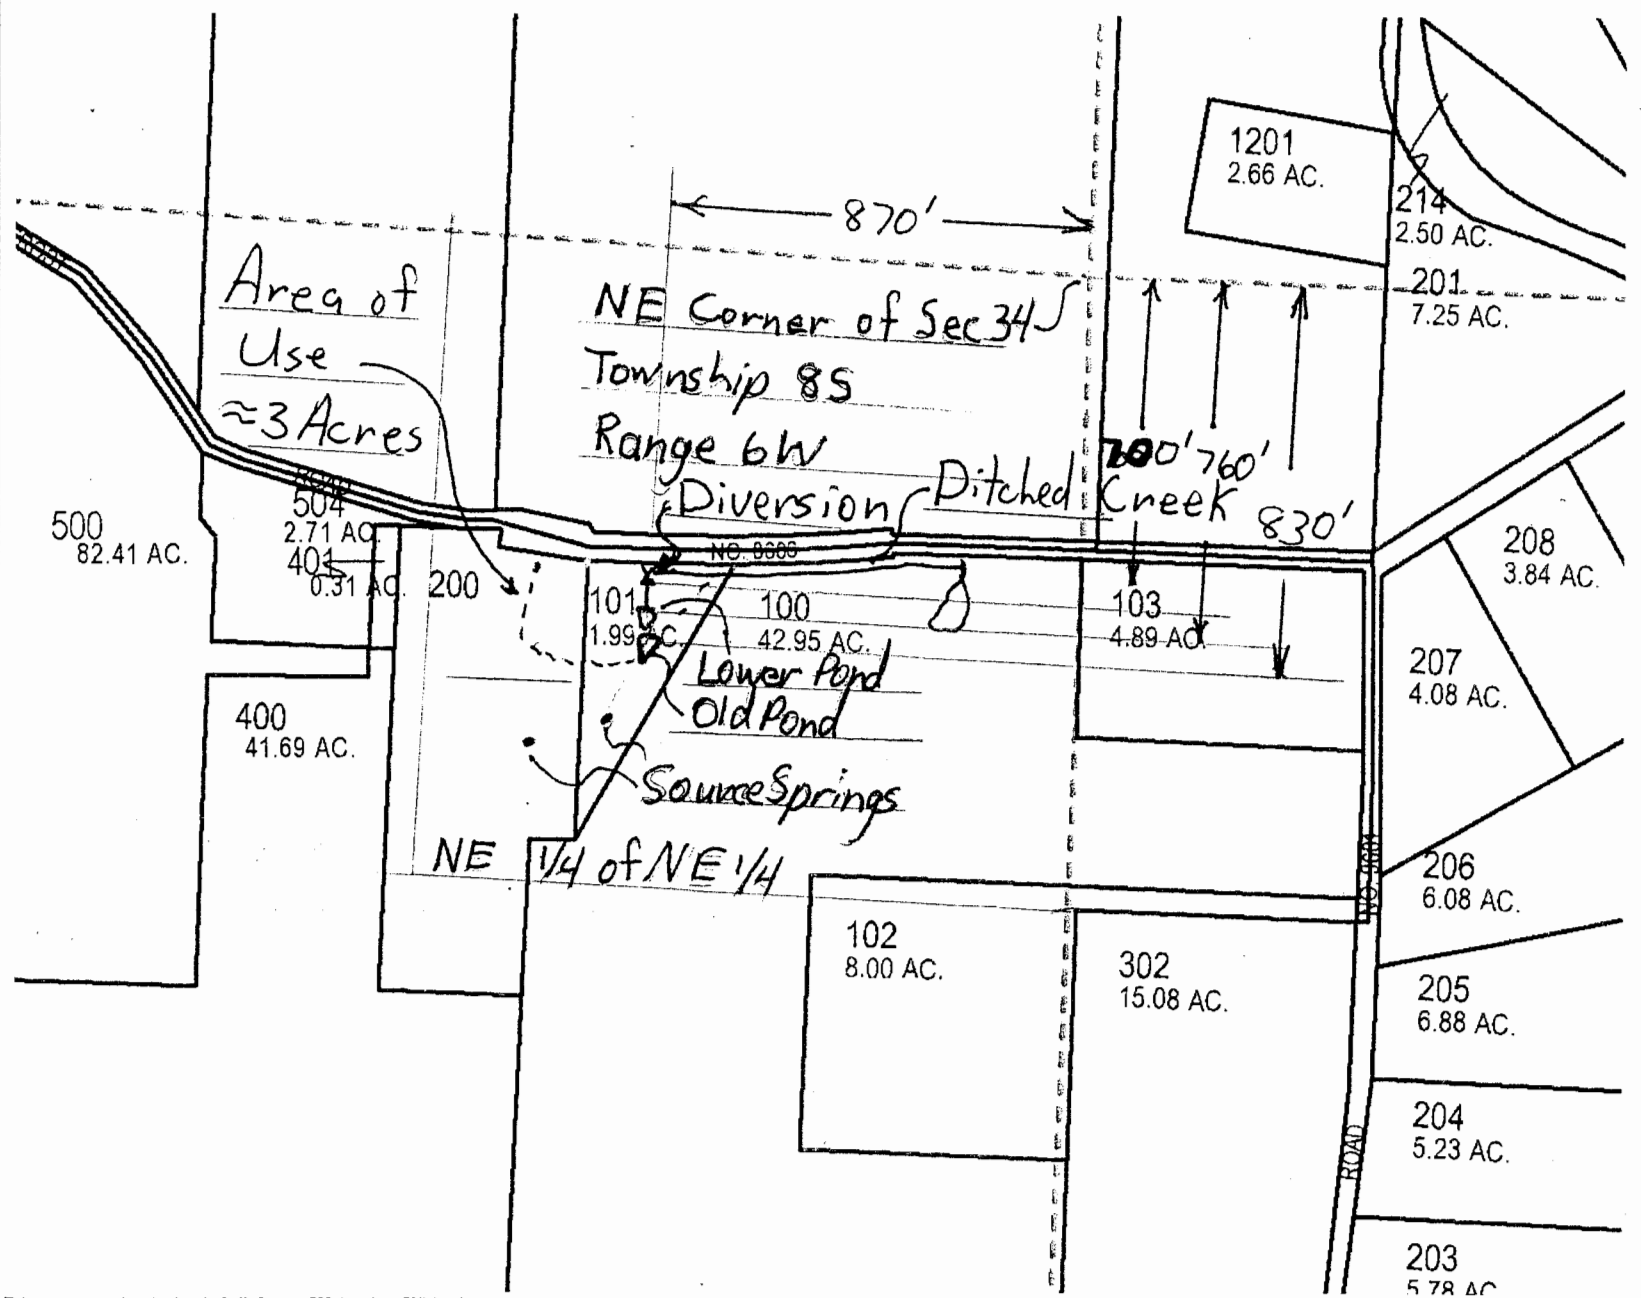

This map was produced using the Polk County GIS data. The GIS data is maintained by the county to support its governmental activities. The county is not responsible for map errors, omissions, misuse or misinterpretation.

1in. = 400 ft.

app no. R86058