

THIS MAP WAS PREPARED FOR ASSESSMENT PURPOSE ONLY

SECTION 32 T.27S. R.11W. W.M. COOS COUNTY


27 11 32

1" = 800 FEET

CANCELLED
400
600
1301
702

SEE MAP 27 11

SEE MAP 28 11 5

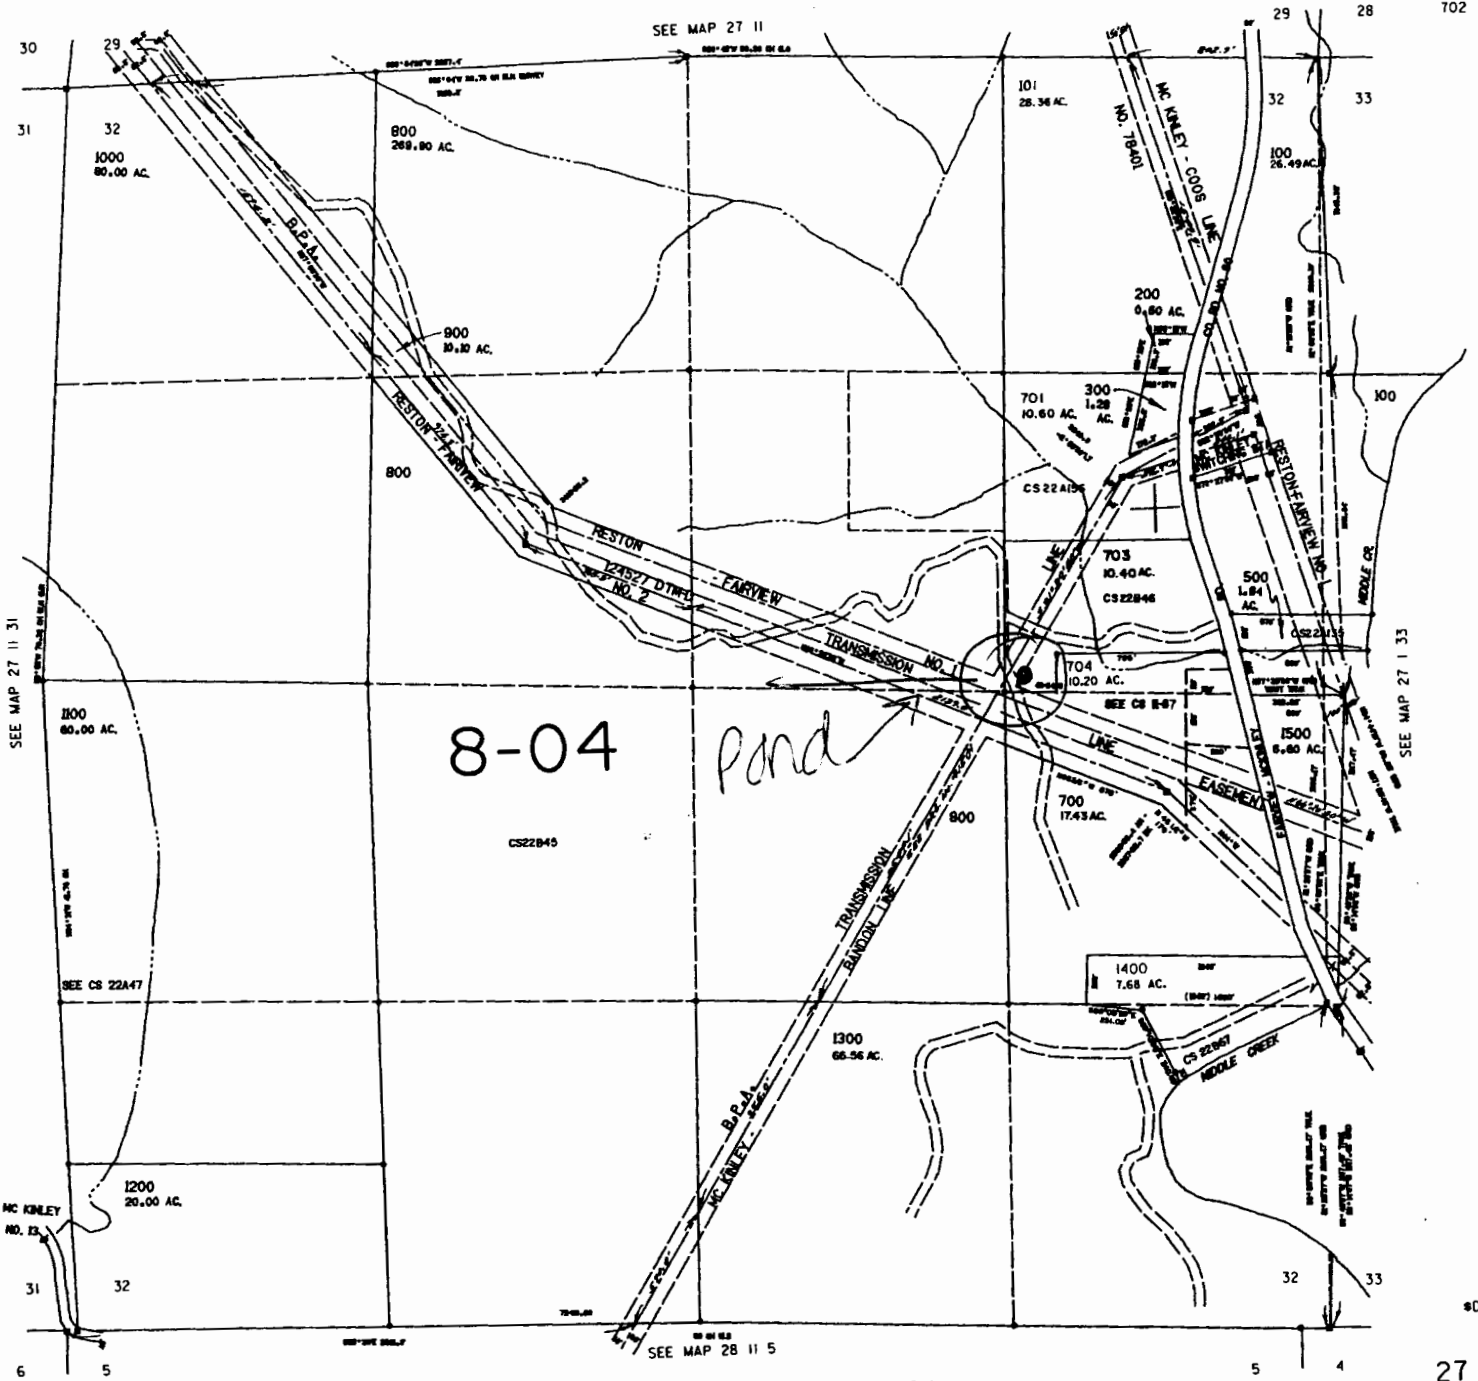

8-04 Pond

WORK COPY ENLARGED

Application R-86038

DATE

27 11 32