

Dr. John Kulus

NEW SCHE

Dallas Service Center



Polk SWCD

1" = 600 FT.


USDA-NRCS

Sue Reams

503-623-5534 x114

Date: 08/24/2004

APPROX.

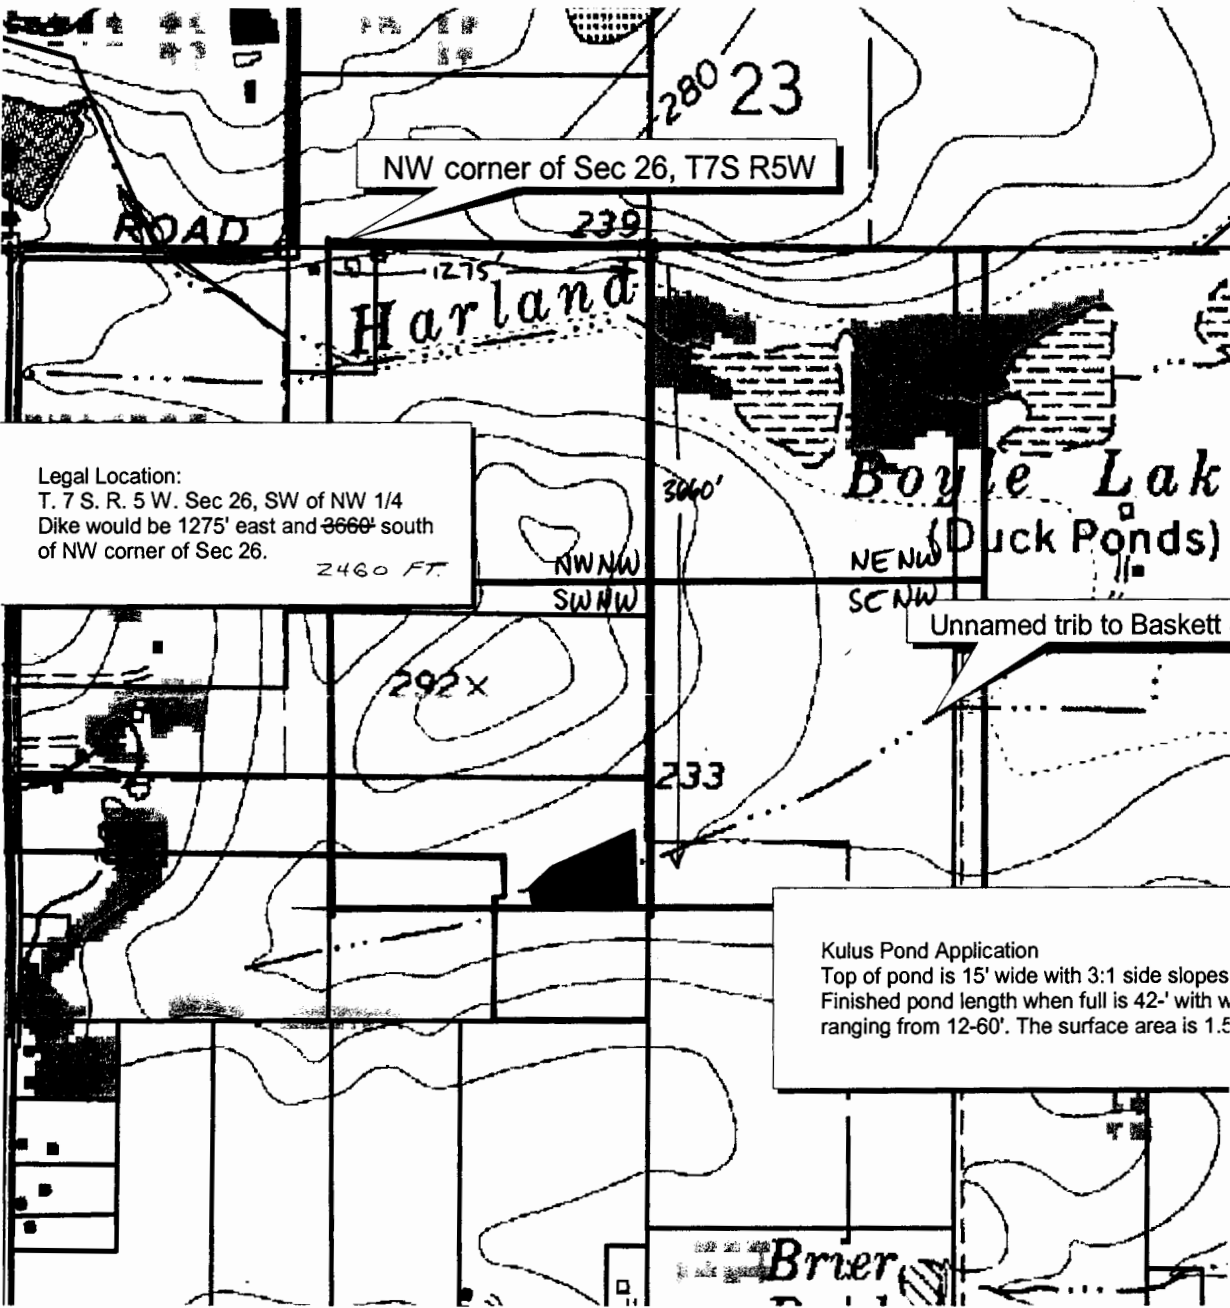

Legend

- John Kulus boundary
- Township Lines
- WL Pond Practice (polygons)
- Taxlot_a_or053.shp

1000 0 1000 2000 Feet

RECEIVED

AUG 26 2004

WATER RESOURCES DEPT
SALEM, OREGON

