


RIVER PROJECT
 GREENWAY PROJECT
 APRIL 1987

MARK
 COPY

RESERVOIR LOCATED
 FROM SE CORNER
 SECTION 23
 SEE MAP 3 IE 22

1730 ft NORTH
 &
 1750 ft WEST

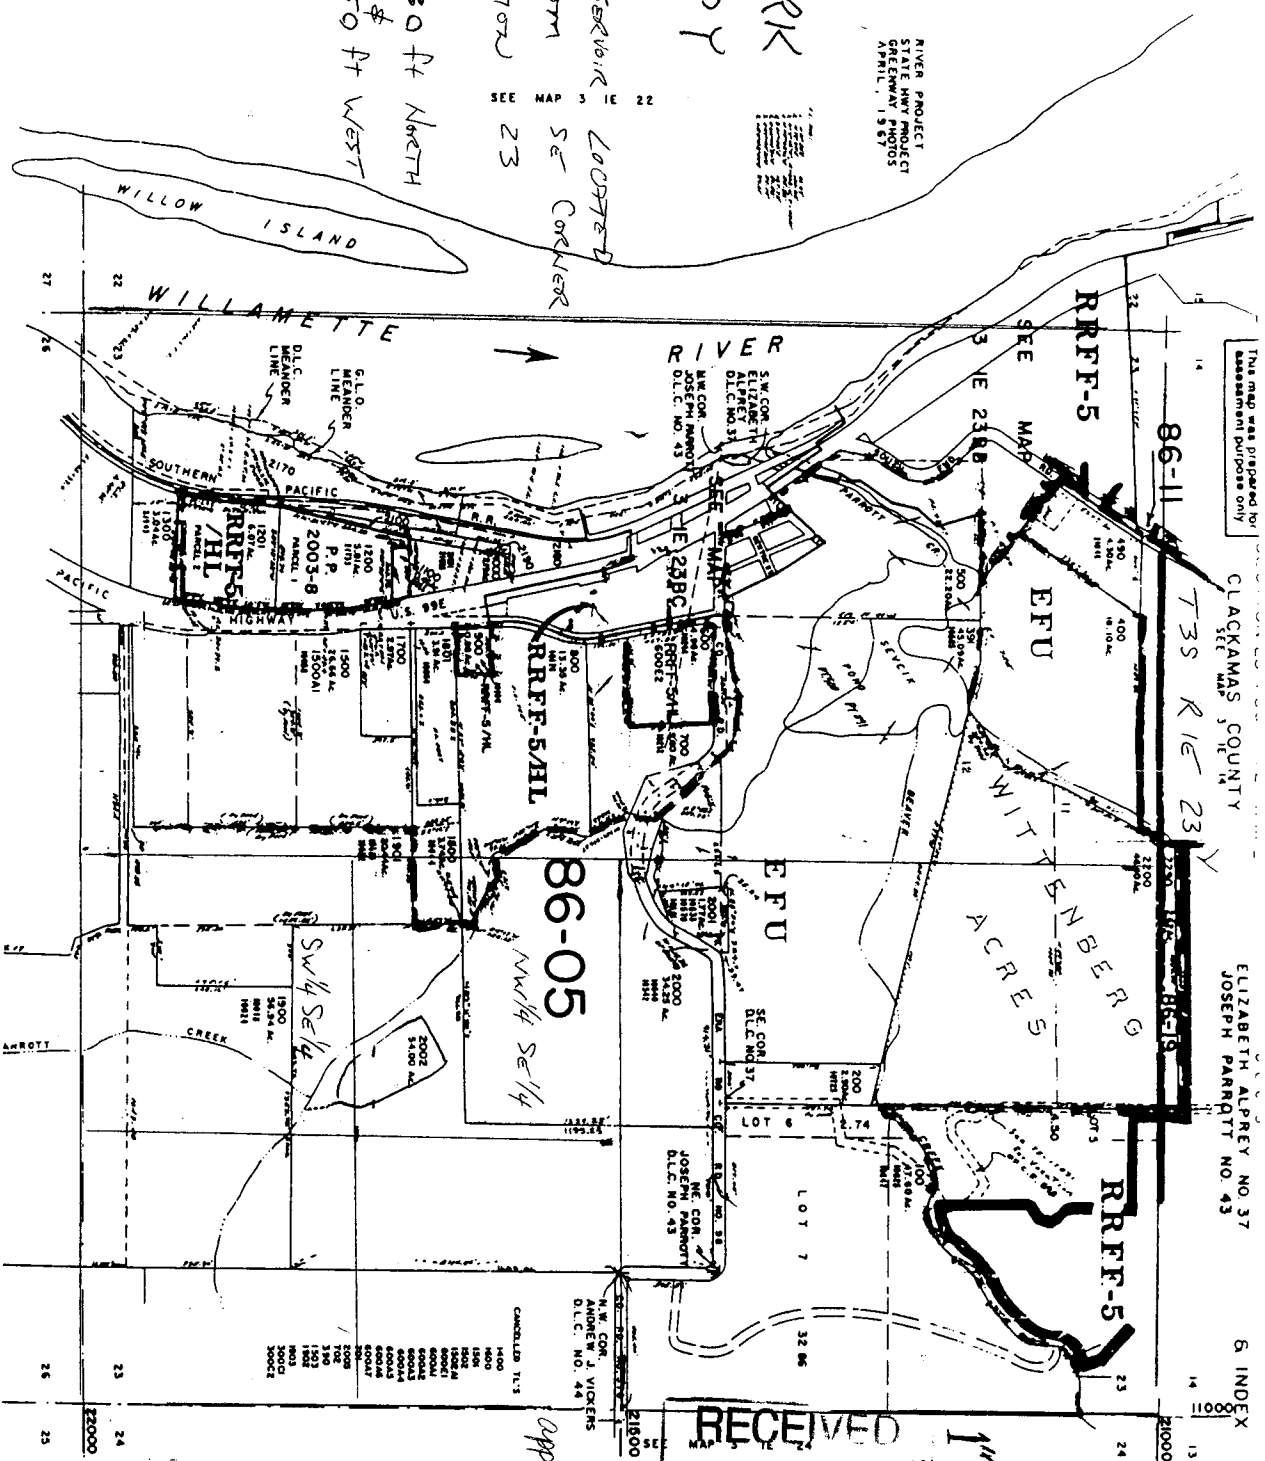

This map was prepared for
 assessment purpose only

CLACKAMAS COUNTY
 SEE MAP 3 IE 23

ELIZABETH ALPREY NO. 37
 JOSEPH PARROTT NO. 43

6 INDEX

RECEIVED
 NOV 15 2004
 WATER RESOURCES DEPT
 SALEM, OREGON

1" = 600'

app R-86132

CANCELLED T.L.S.

