



WORK COPY

PLACE OF USE BY 1/4, 1/4 SECTION			
SEC	1/4, 1/4	PRIMARY RIGHT	SUPPLEMENTARY RIGHT
23	NW/SW	0.14 AC	0.73 AC
	NE/SW	4.27 AC	0.39 AC
	SW/SW	11.00 AC	12.29 AC
	SE/SW	12.54 AC	1.70 AC
22	NE/SE	0.23 AC	--
	SE/SE	1.62 AC	--
TOTAL		29.80 AC	15.11 AC

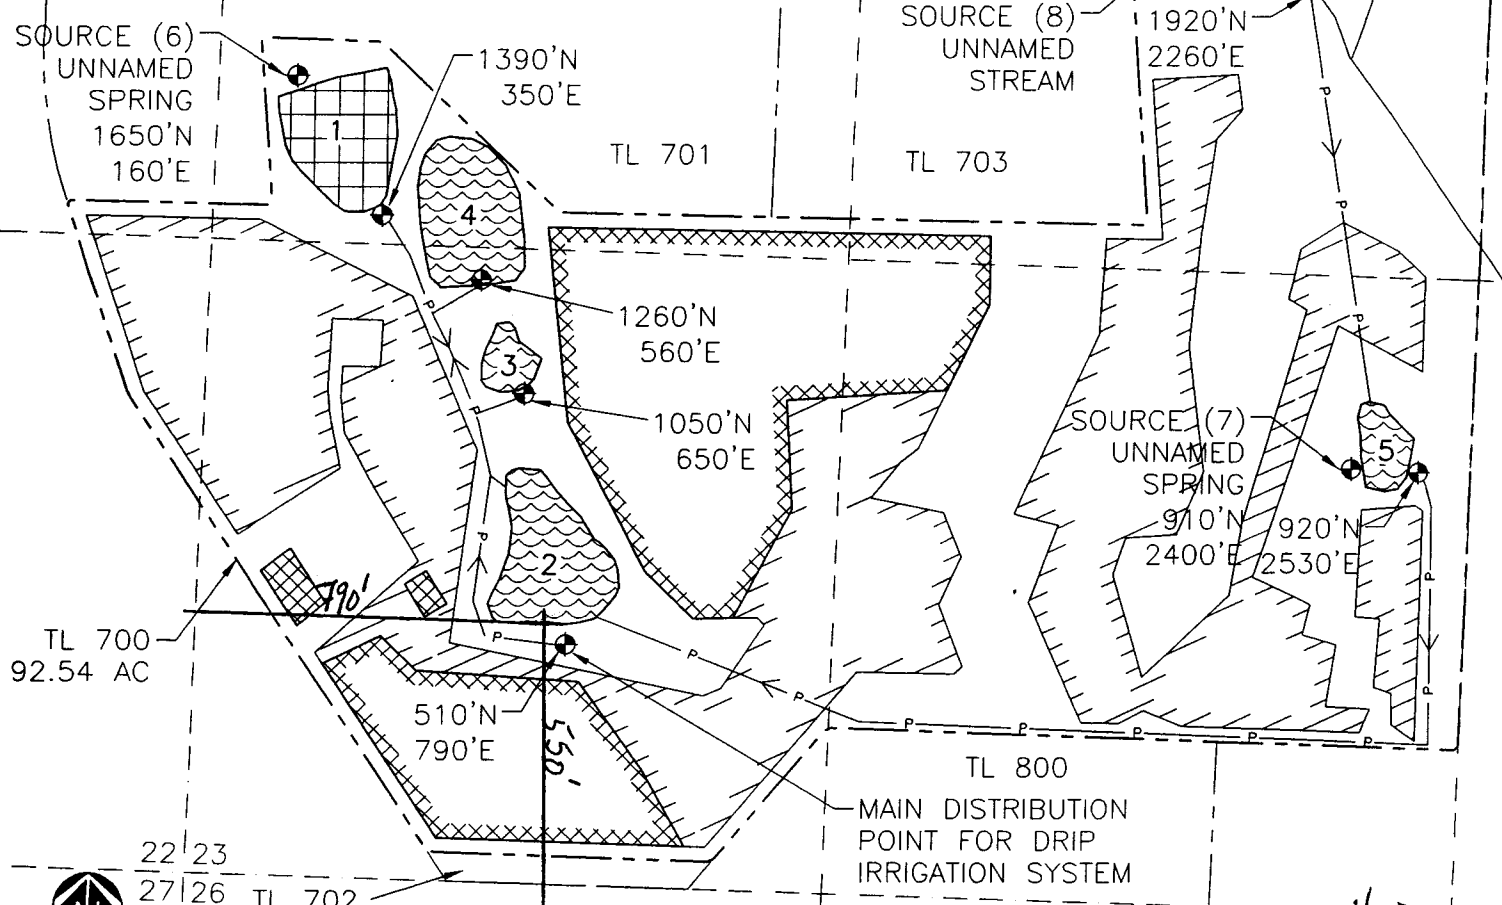

RESERVOIR APPLICATION MAP

RESERVOIR # 2  
550' N & 790' E

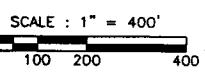

IN THE NAME OF:  
ZENA HEIGHTS VINEYARD, LLC  
NOVEMBER 2004  
T.6S, R.4W, W.M. SECTION 22 AND 23

From SW  
CORNER  
Section  
23

**RECEIVED**  
DEC 30 2004  
WATER RESOURCES DEPT  
SALEM, OREGON

LEGEND

- POINT OF DIVERSION
- RESERVOIR TRANSFER PIPE (2")
- PROPERTY LINE
- SECTION LINE
- PROPOSED RESERVOIR (NO.)
- EXISTING RESERVOIR (NO.)
- PROPOSED PLACE OF USE (PRIMARY RIGHT)
- CERTIFICATE PLACE OF USE (SUPPLEMENTAL RIGHT)

NOTES:

1. Point of Diversion coordinates are identified relative to SW corner of Section 23.
2. This map is for the purpose of identifying the location of the water right only and is not intended to provide legal dimensions or locations of property lines.
3. Reservoir locations represent water surface areas and do not include the reservoir embankments.

app # R-86141