


REC'D APR 16 2004

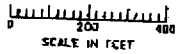

WORK COPY

Scale 1" = 400 FT


Pond located 300' South and 400' West of NE 1/16 Corner. T5N R27 E Sec. 21 SW 1/4 of NE 1/4

Map Full size Max Copy Part of Full size Map.



Pond located 330' South and 400' West of NE 1/16 Corner of Sec. 21 T5N R27 East SW 1/4 of NE 1/4 Tax Lot 5700

RESERVOIR LOCATED FROM NE CORNER SECTION 21 1680 FT SOUTH & 1740 FT WEST

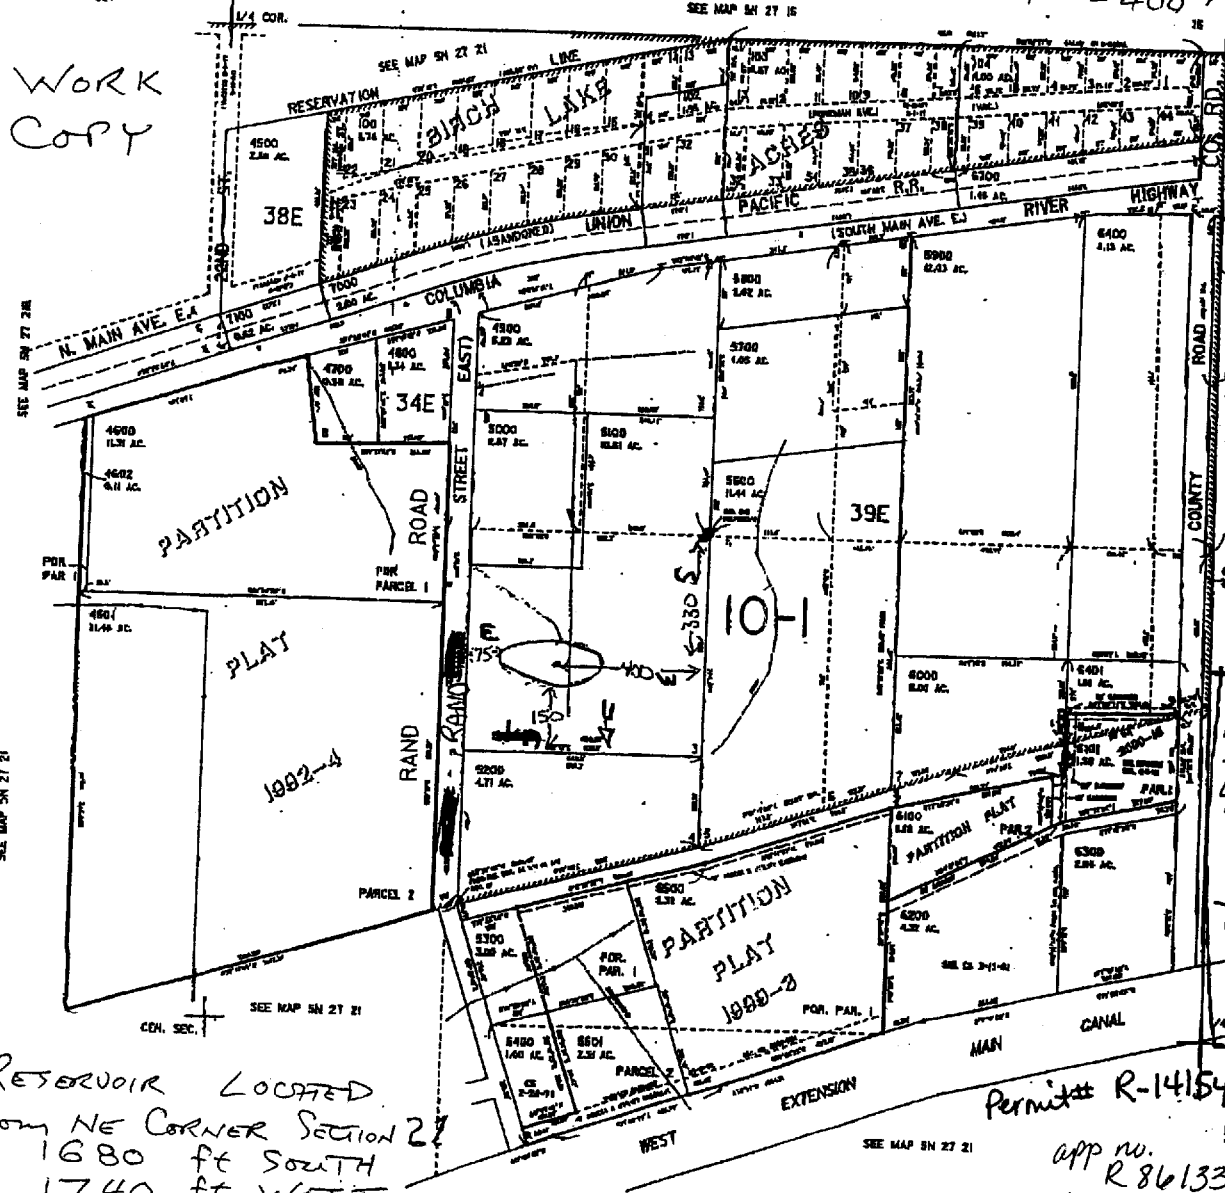

Permit R-14154 app no. R86133

