Jim Schedt – 3810 Limestone Rd, Dallas, OR. 97338

Polk County Map

T 08S – R 6W – S 12 SW¼/SW¼

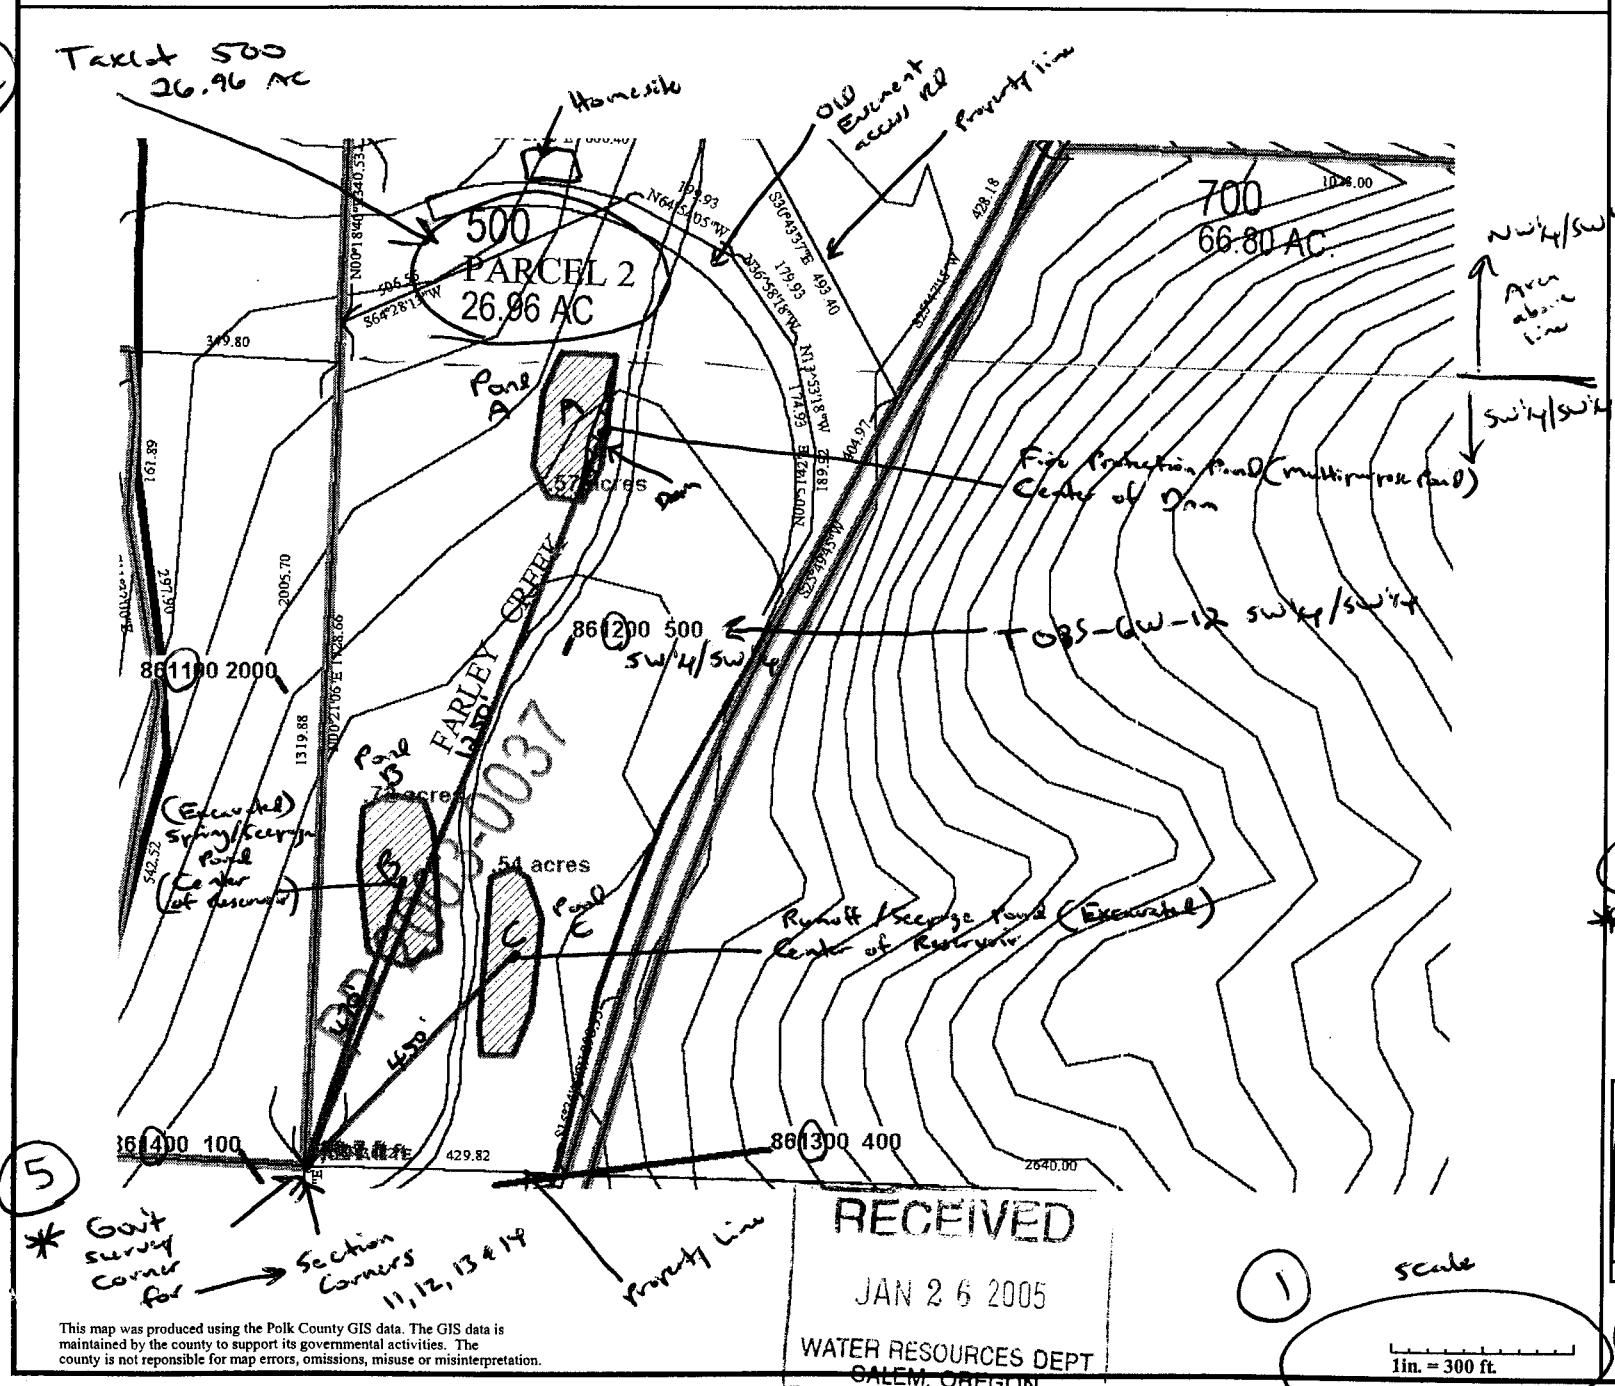

Community Development

- Contours
- Roads
  - OTHER
  - CO-GRAVEL
  - STATEHWY
  - CO-PAVED
- Taxlot05
  - Taxlot Arrows05
  - Taxlot Boundary2
  - Taxlot05
- TaxMap
  - TaxMap Line
    - 22
    - 24
    - 26
    - 32
    - 33
    - 34
    - 8
    - 47
  - TaxMap Sub Line
  - TaxMapAr

Pond Description

Pond A 1250' North 390' East

Pond B 470' North 140' East

Pond C 450' North 300' East

All three ponds are located in SW¼/SW¼

RECEIVED
JAN 26 2005
WATER RESOURCES DEPT
SALEM, OREGON

This map was produced using the Polk County GIS data. The GIS data is maintained by the county to support its governmental activities. The county is not reponsible for map errors, omissions, misuse or misinterpretation.