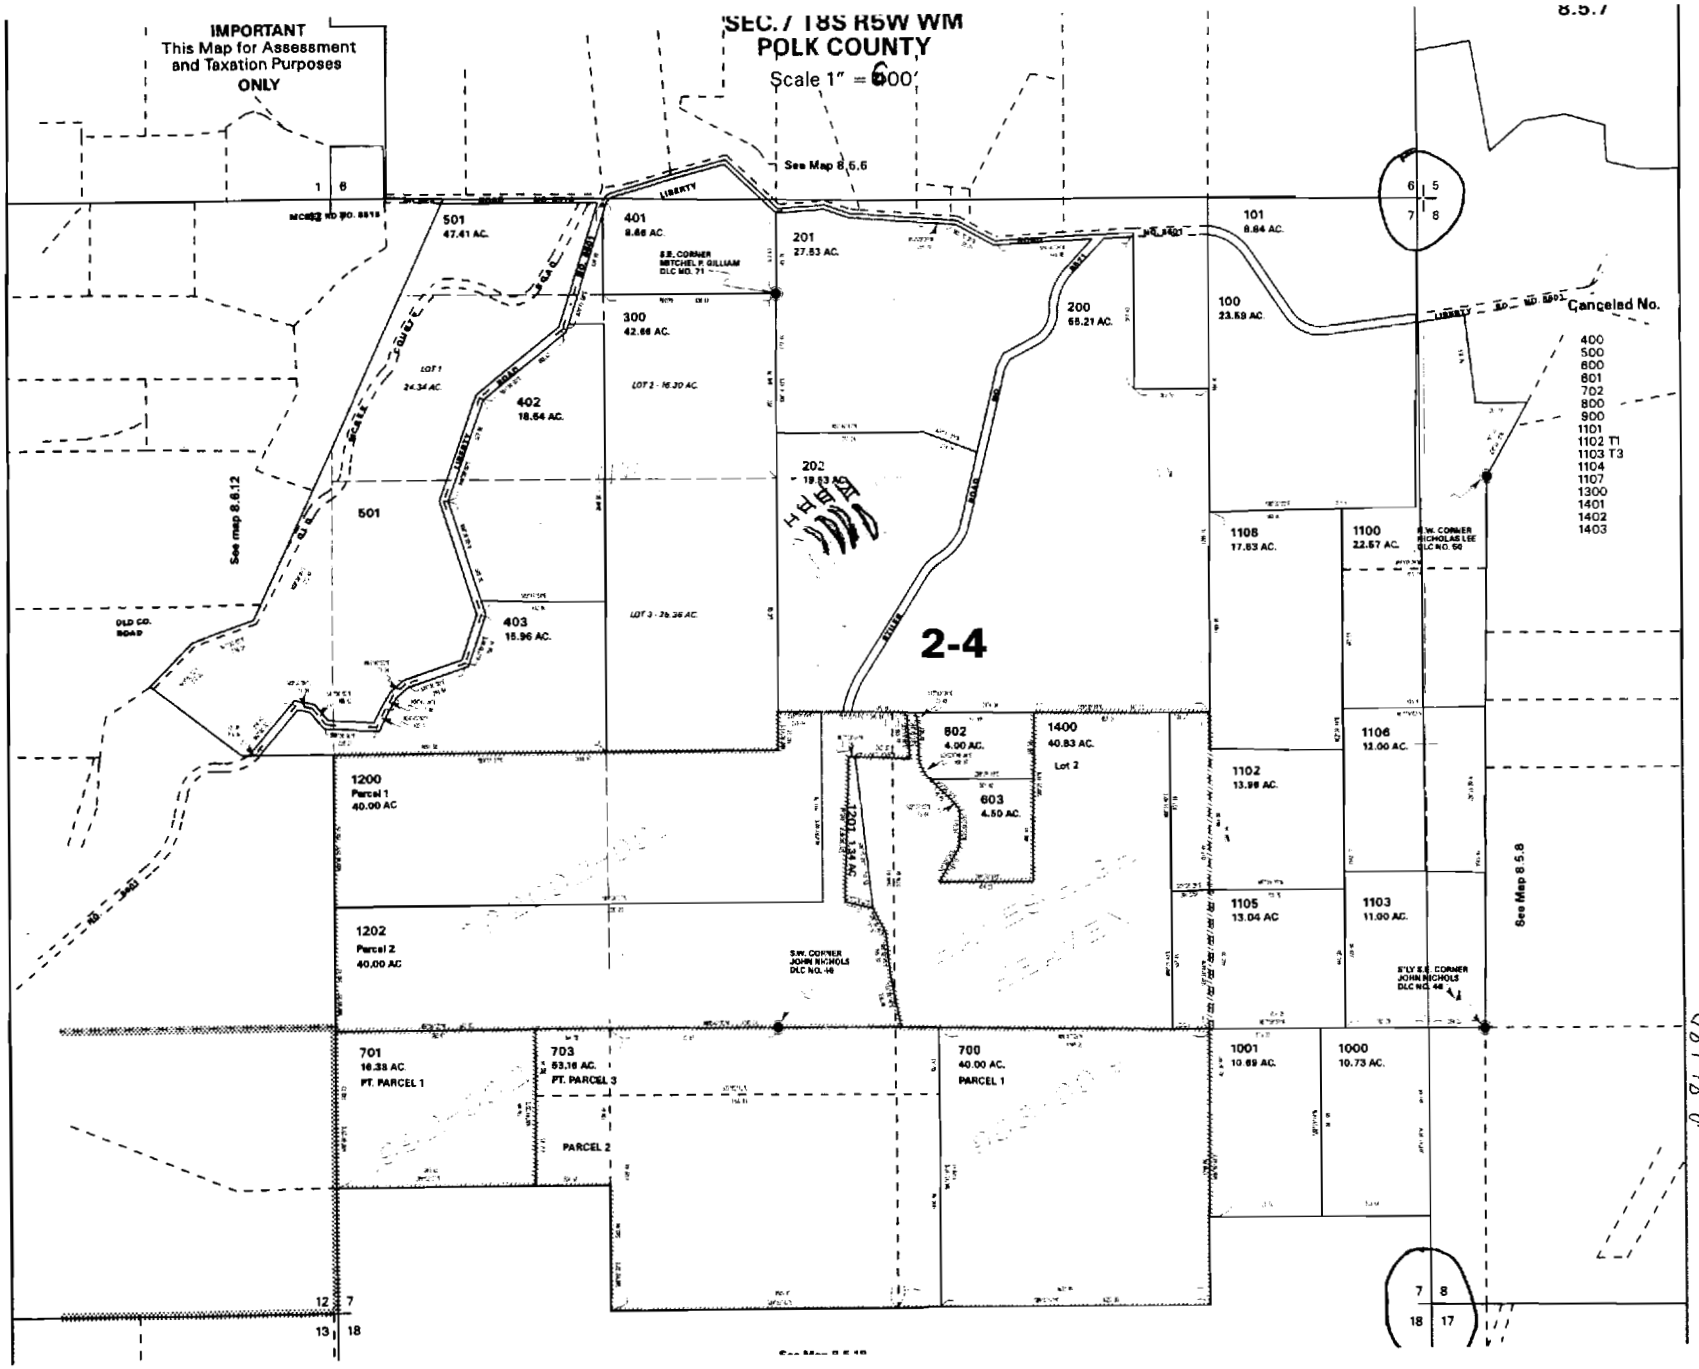

ALL BOUNDS MEASURED from NE CORNER SECTION 7

I 1600 FT SOUTH AND 2910 FT WEST
II 1560 FT SOUTH AND 2840 FT WEST
III 1530 FT SOUTH AND 2775 FT WEST
IV 1640 FT SOUTH AND 2650 FT WEST

25 FEB 05

app # R 86180