

SE/NE 0.75 Ac  
 NE/SE 20.5 Ac  
 NW/SE 1.5 Ac  
 SE/SE 0.65 Ac

TOTAL 23.40 ACRES  
 PRIMARY

RECEIVED  
 MAR 23 2005  
 WATER RESOURCES DEPT.  
 SALEM, OREGON

RECEIVED  
 MAR 23 2005  
 WATER RESOURCES DEPT.  
 SALEM, OREGON

app # R 86211

ITD 3/23/05  
 Assessor SCRCG  
 LEGEND  
 1" = 800 Feet  
 LINE TYPES  
 TAX LOT BOUNDARY OLD PROPERTY LINE  
 ROAD RIGHT-OF-WAY VACATED RIGHT-OF-WAY  
 RAILROAD RAILROAD RIGHT-OF-WAY  
 STREAM LAKE ETC. TAX LOT BOUNDARY STREAM LAKE ETC. NON-BOUNDARY  
 SUBDIVISION BOUNDARY PARTITION PLAT BOUNDARY  
 TAX CODE BOUNDARY EASEMENT

SYMBOL TYPES  
 B.L.C.  
 CONTROL POINT  
 SURVEY MONUMENT  
 G.L.A. CORNER  
 SECTION 1/4 SEC. 1/8 SEC. 1/16 SEC.


NUMBERS  
 TAX CODE NO.  
 000 00 00 0  
 ACREAGE - ALL ACREAGES INCLUDE ANY PORTION THAT MAY LIE WITHIN THE INDICATED PUBLIC RIGHT OF WAY.  
 THE MARKS - WHEN A TIE MARK IS INDICATED BY THE ABBREVIATION OF A LAND, THEN THE ABBREVIATION GOES TO THE TIE MARK, USUALLY THIS IS WITH YOUR BOUNDARIES OR WITH PUBLIC RIGHT OF WAY.  
 ABBREVIATIONS ARE USED WITH RESERVATIONS IN AREAS OF GREATER COMPLEXITY.

NOTICE: This map was created for Assessor's Office use ONLY.



800  
 SCALE 1" = 400'  
 OF 1:4000

Plot file created: December 09, 2003

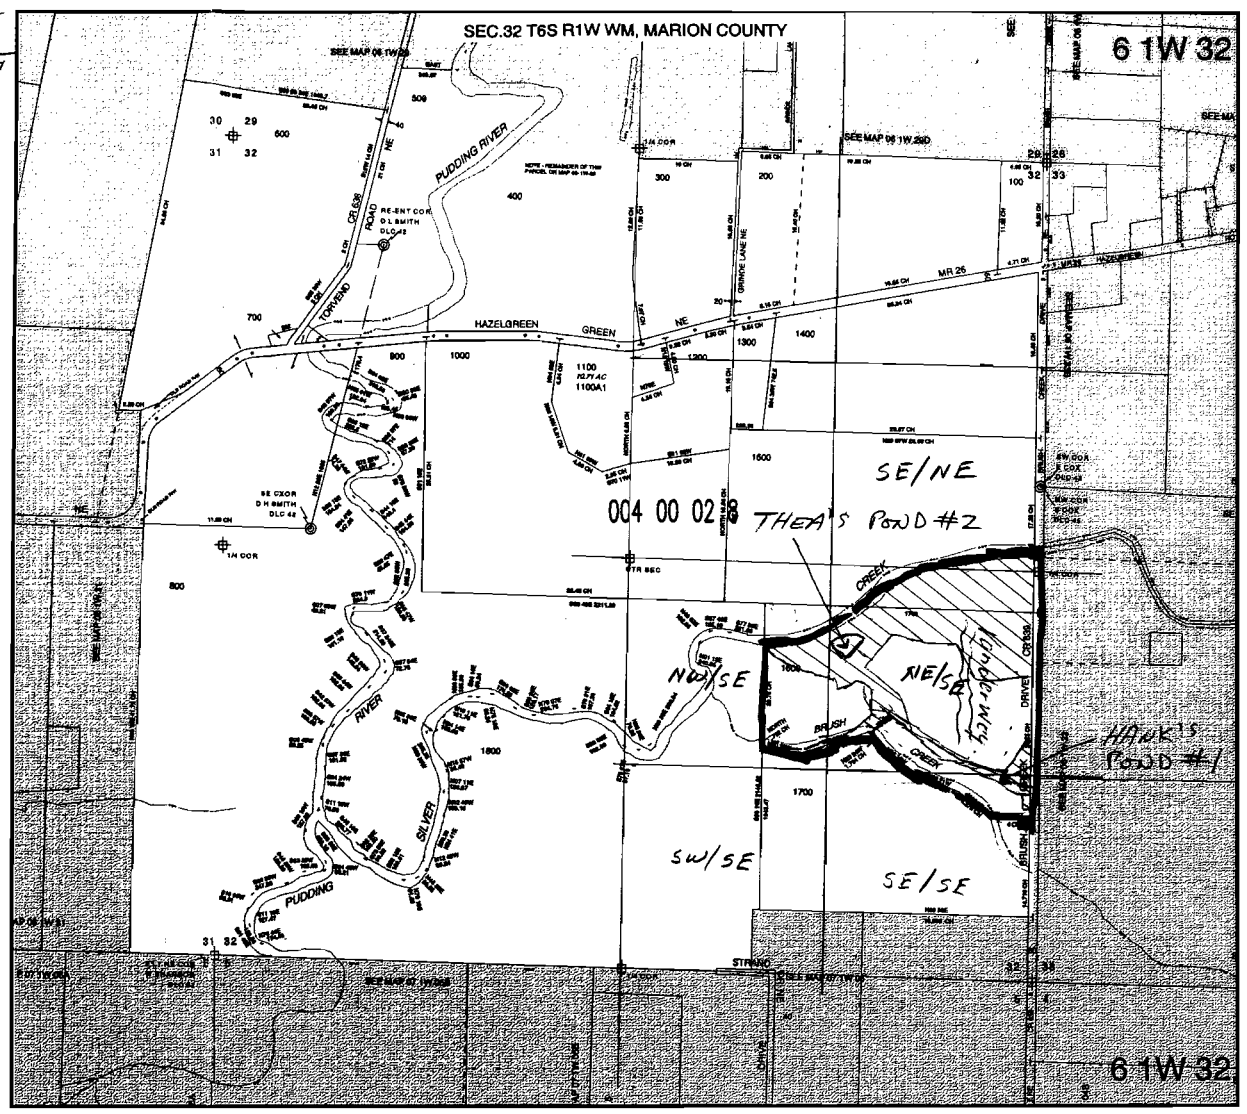

THEA'S POND #2 NE 1/4 SE 1/4  
 LOCATED from SE CORNER  
 SECTION 32  
 2120 FE NORTH  
 1200 FE WEST

HANK'S POND #1  
 POND MEASURED FROM  
 SE CORNER SECTION 32  
 1640 FE NORTH  
 1000 FE WEST