




RECEIVED
JUN 20 2005
WATER RESOURCES DEPT
SALEM, OREGON

1" = 400'

SEE MAP 39 8 27

NW CORNER
SEC 34

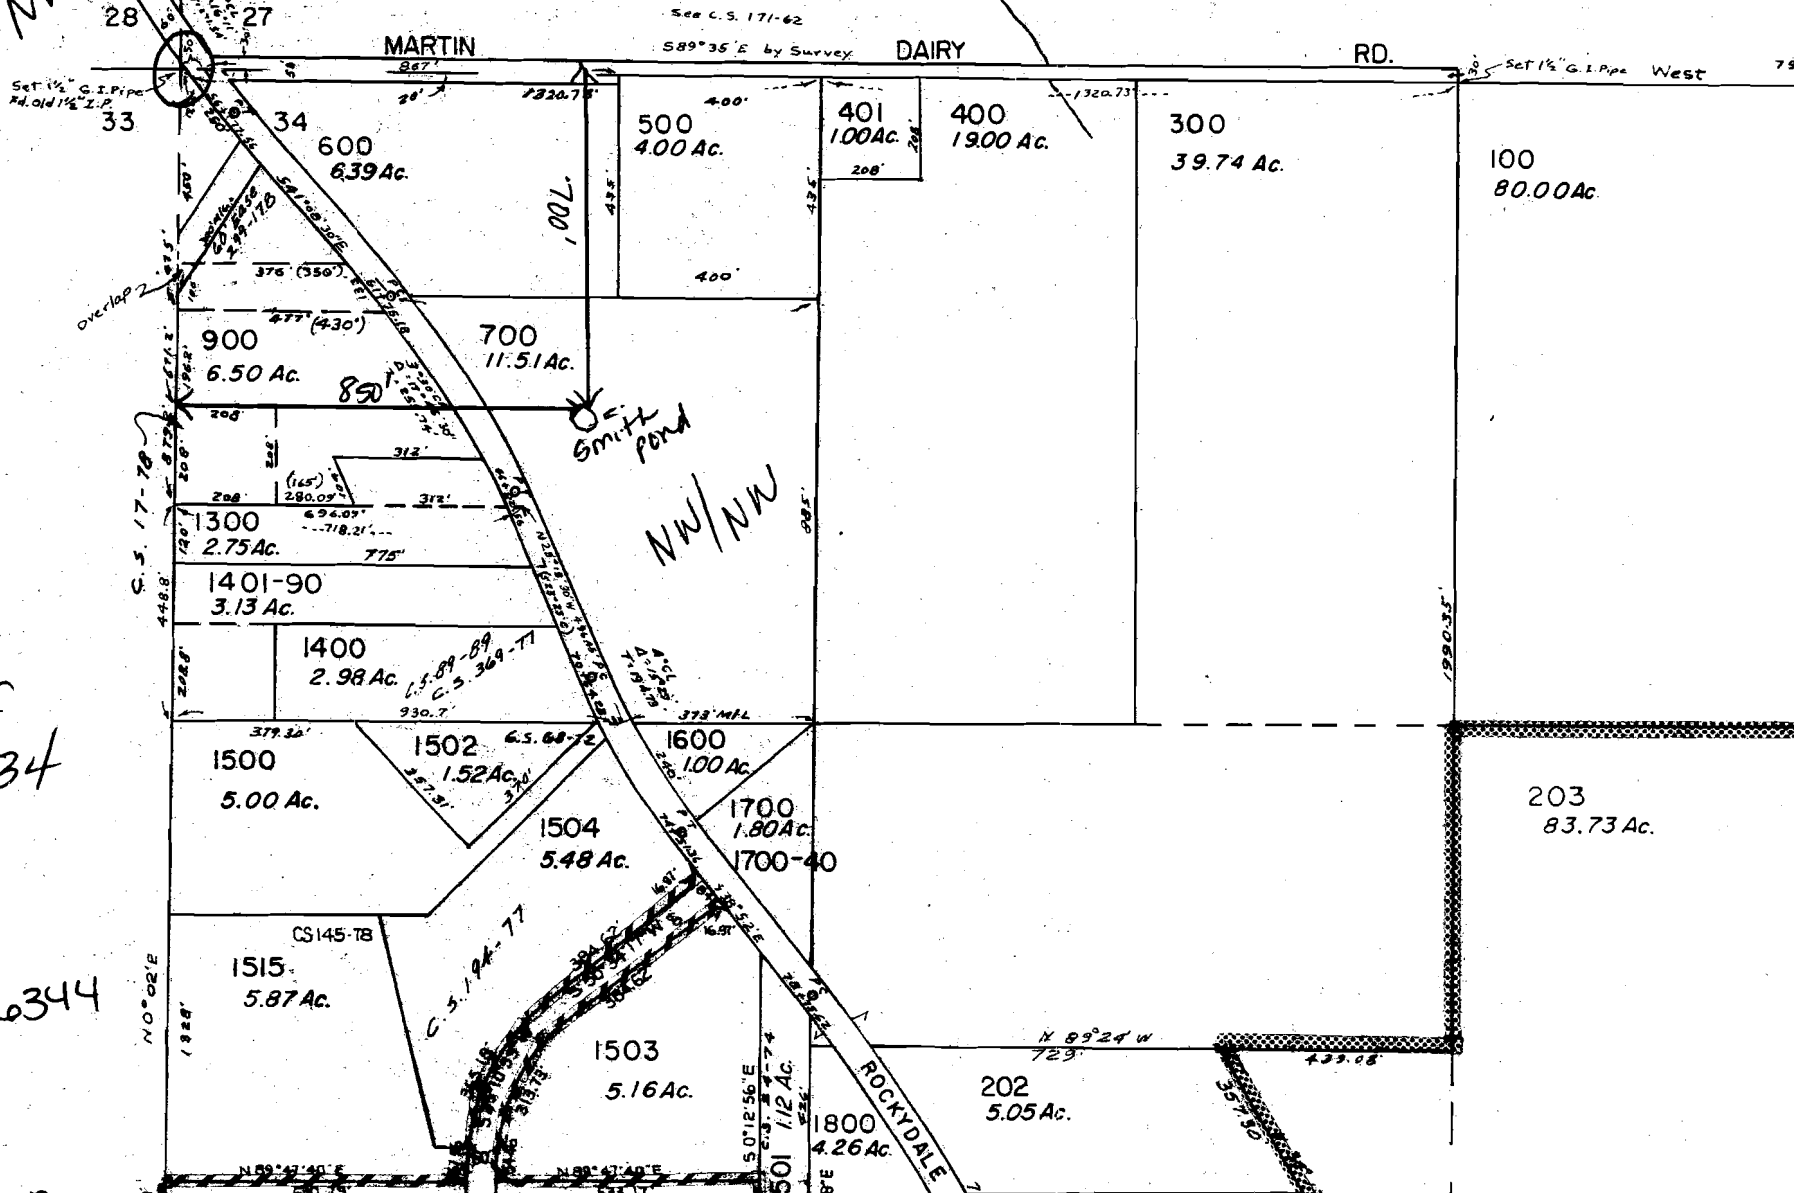

700' South
and
850' East
of NW
Corner of
Section 34

app no R-86344