


SEC.23 T.26S. R.6W. W.M.
DOUGLAS COUNTY
Scale: 1" = 1000'

RECEIVED
MAY 05 2005
WATER RESOURCES DEPT
SALEM, OREGON

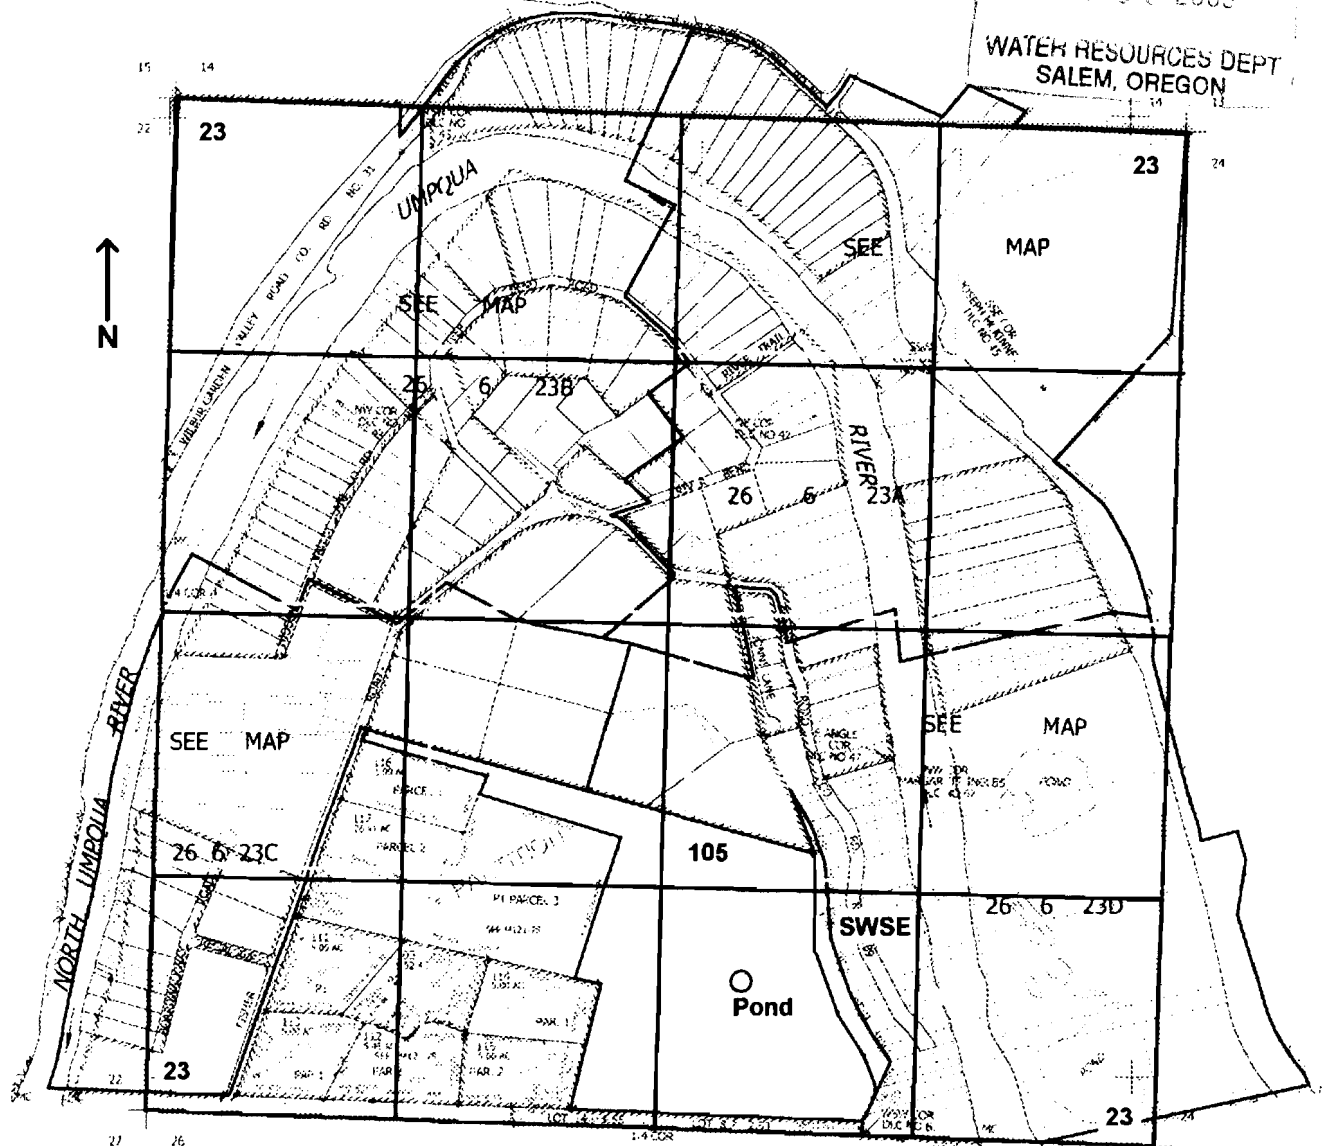

Pond is located 780 ft. N. and 420 ft. E. from the S. 1/4 corner of Sec. 23

app # R 86299