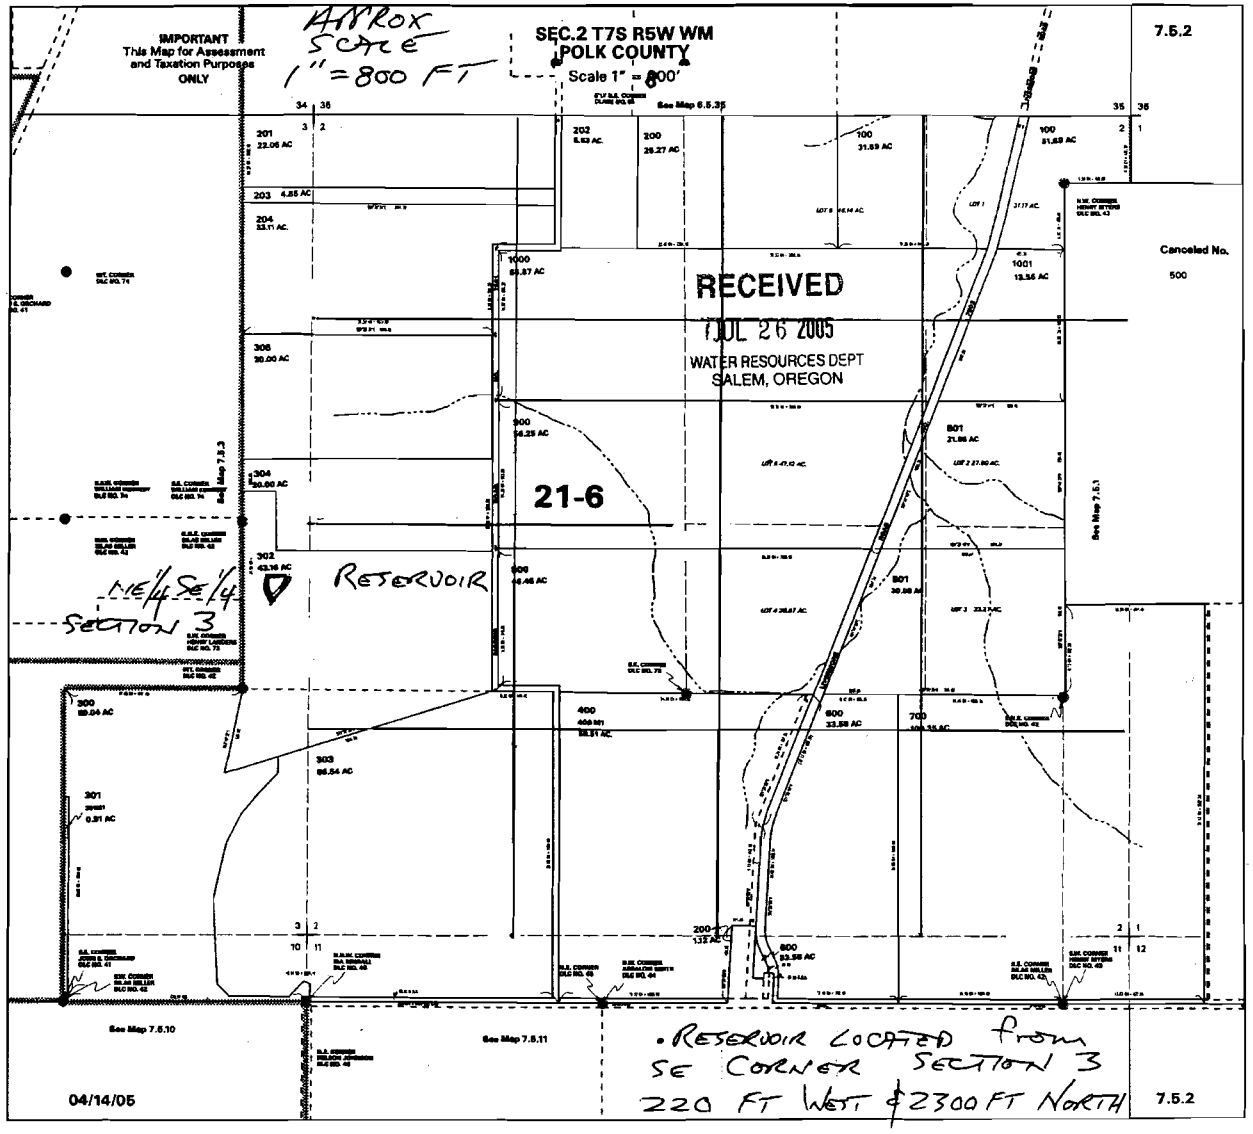

App No R 86385 Permit No