

RECEIVED

NOV 15 2005

WATER RESOURCES DEPT
SALEM, OREGON

SURVEY


FOR

H. D. GORMAN

SECTION 3 T10 S R6W WM. POLK COUNTY, OREGON

OCT 7, 1967

S R6W
S R6W

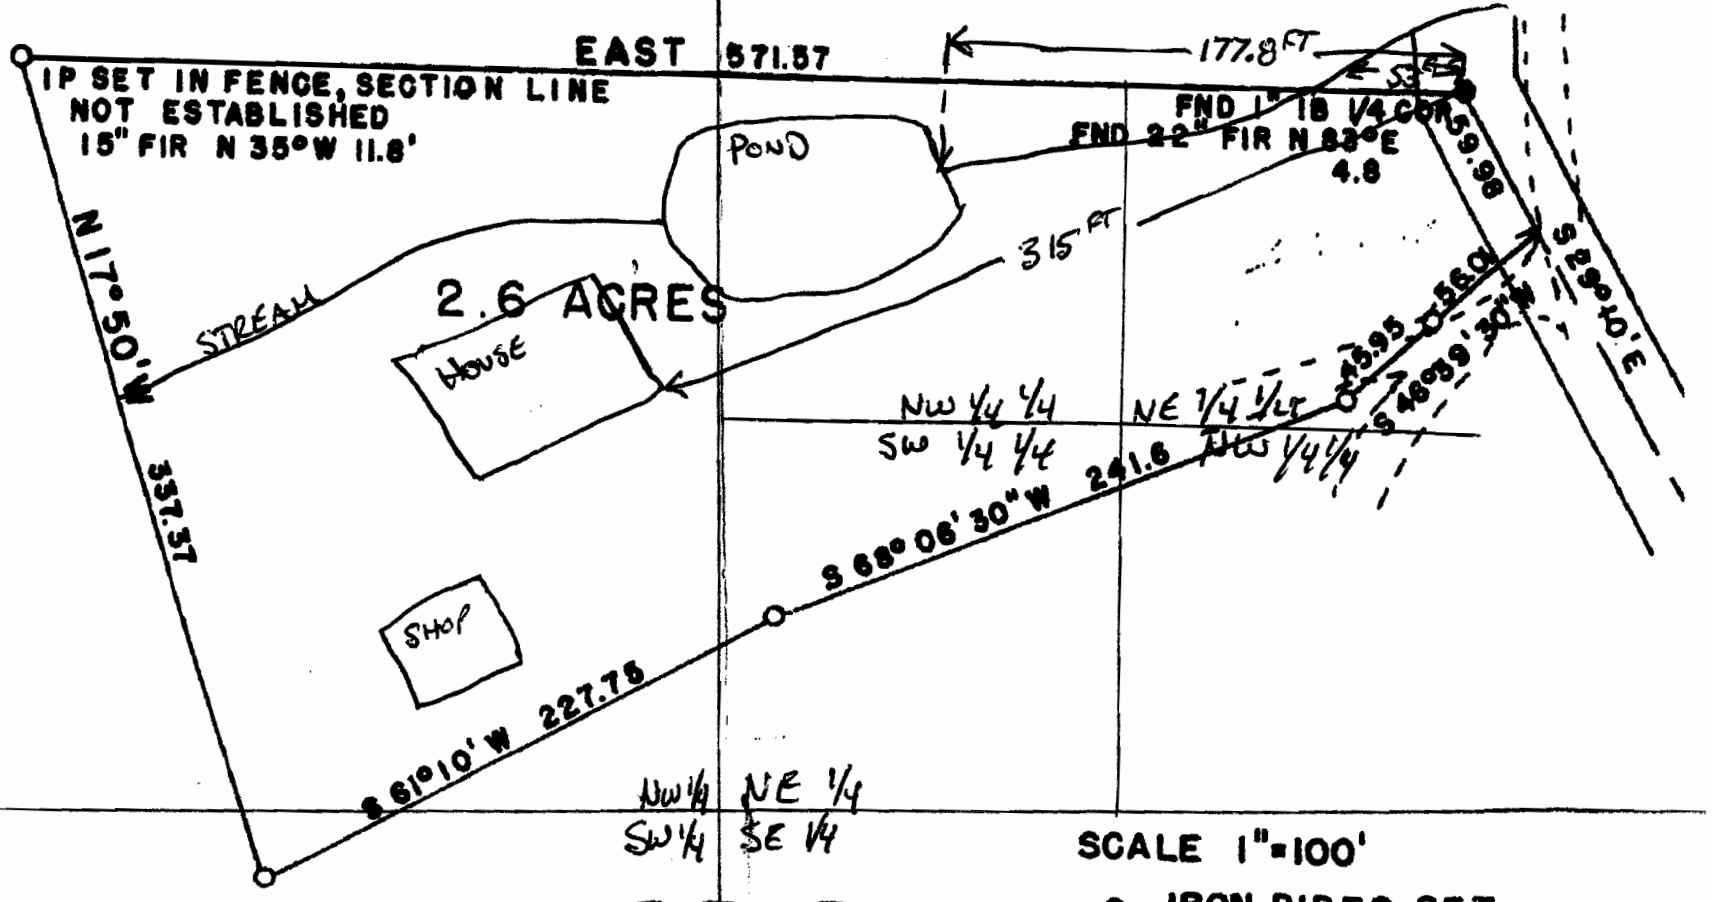

REGISTERED
GORMAN
SURVEYOR

SCALE 1"=100'

- IRON PIPES SET
- MONUMENTS FOUND

SECTION 3

H. Blanchard approx R 86483