

Josephine Co.


SEE MAP

TRS:

37S-5W-25-NE/SW




1350' East  
and  
2100' North  
of the  
SW 1/4 Corner

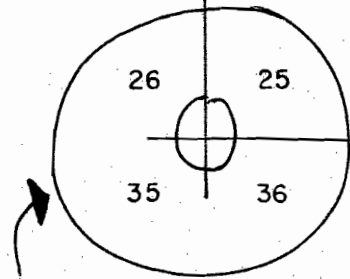

SW 1/4  
Corner

app no R 86408  
Permit no

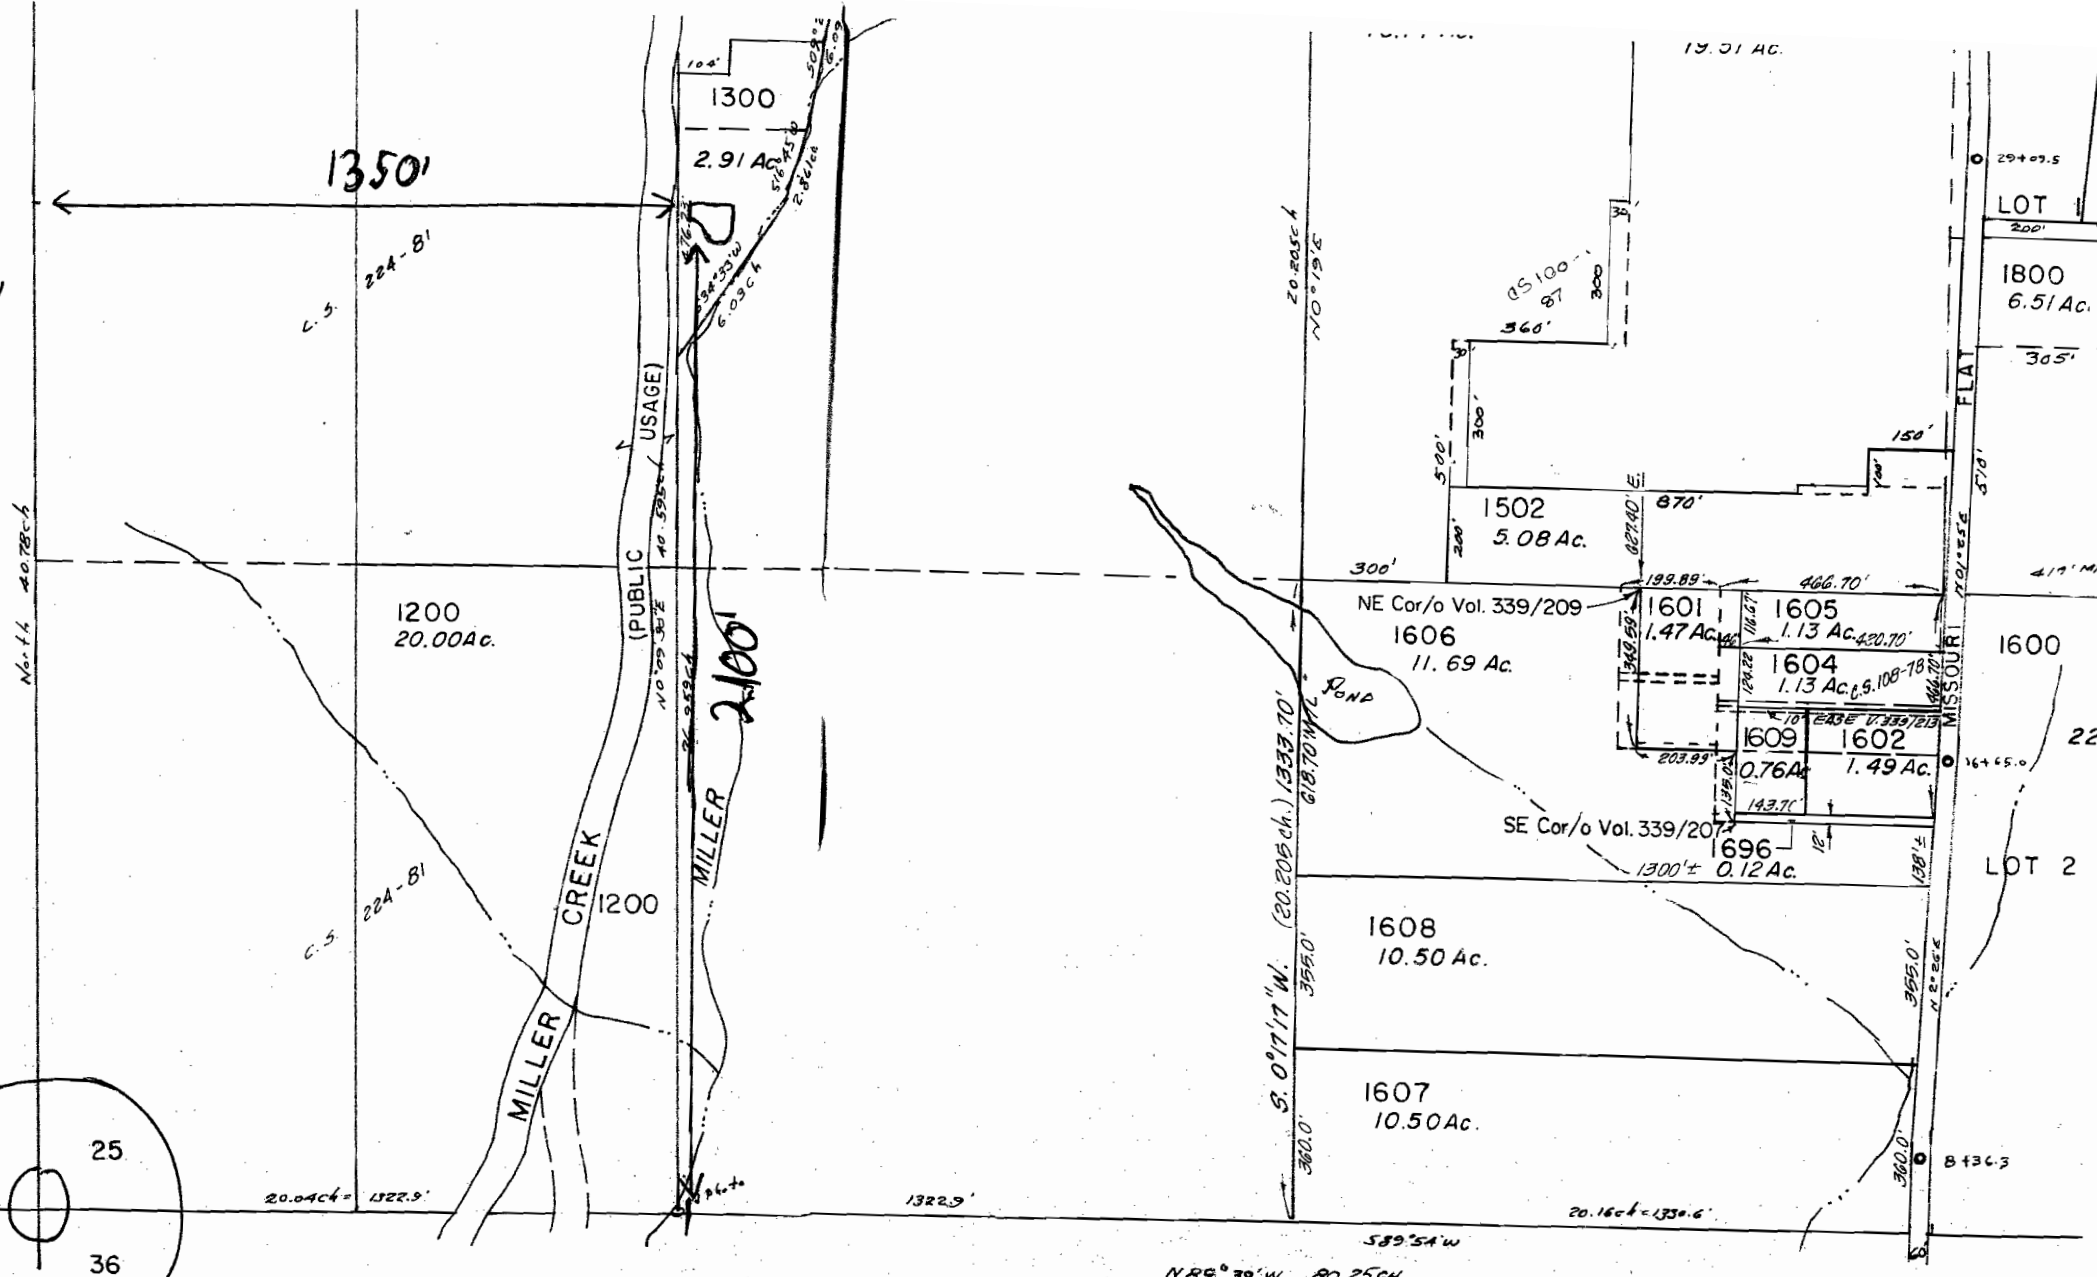

Scale  
1" = 400'

SEE MAP 37 5 36