


COLLECTED
APPROX SCALE
1" = 400 FT.

WORK
COPY

POD
PUMP POSITION
POND #1
LOCATED FROM
SW CORNER
SECTION 3
2170 FT NORTH
780 FT EAST

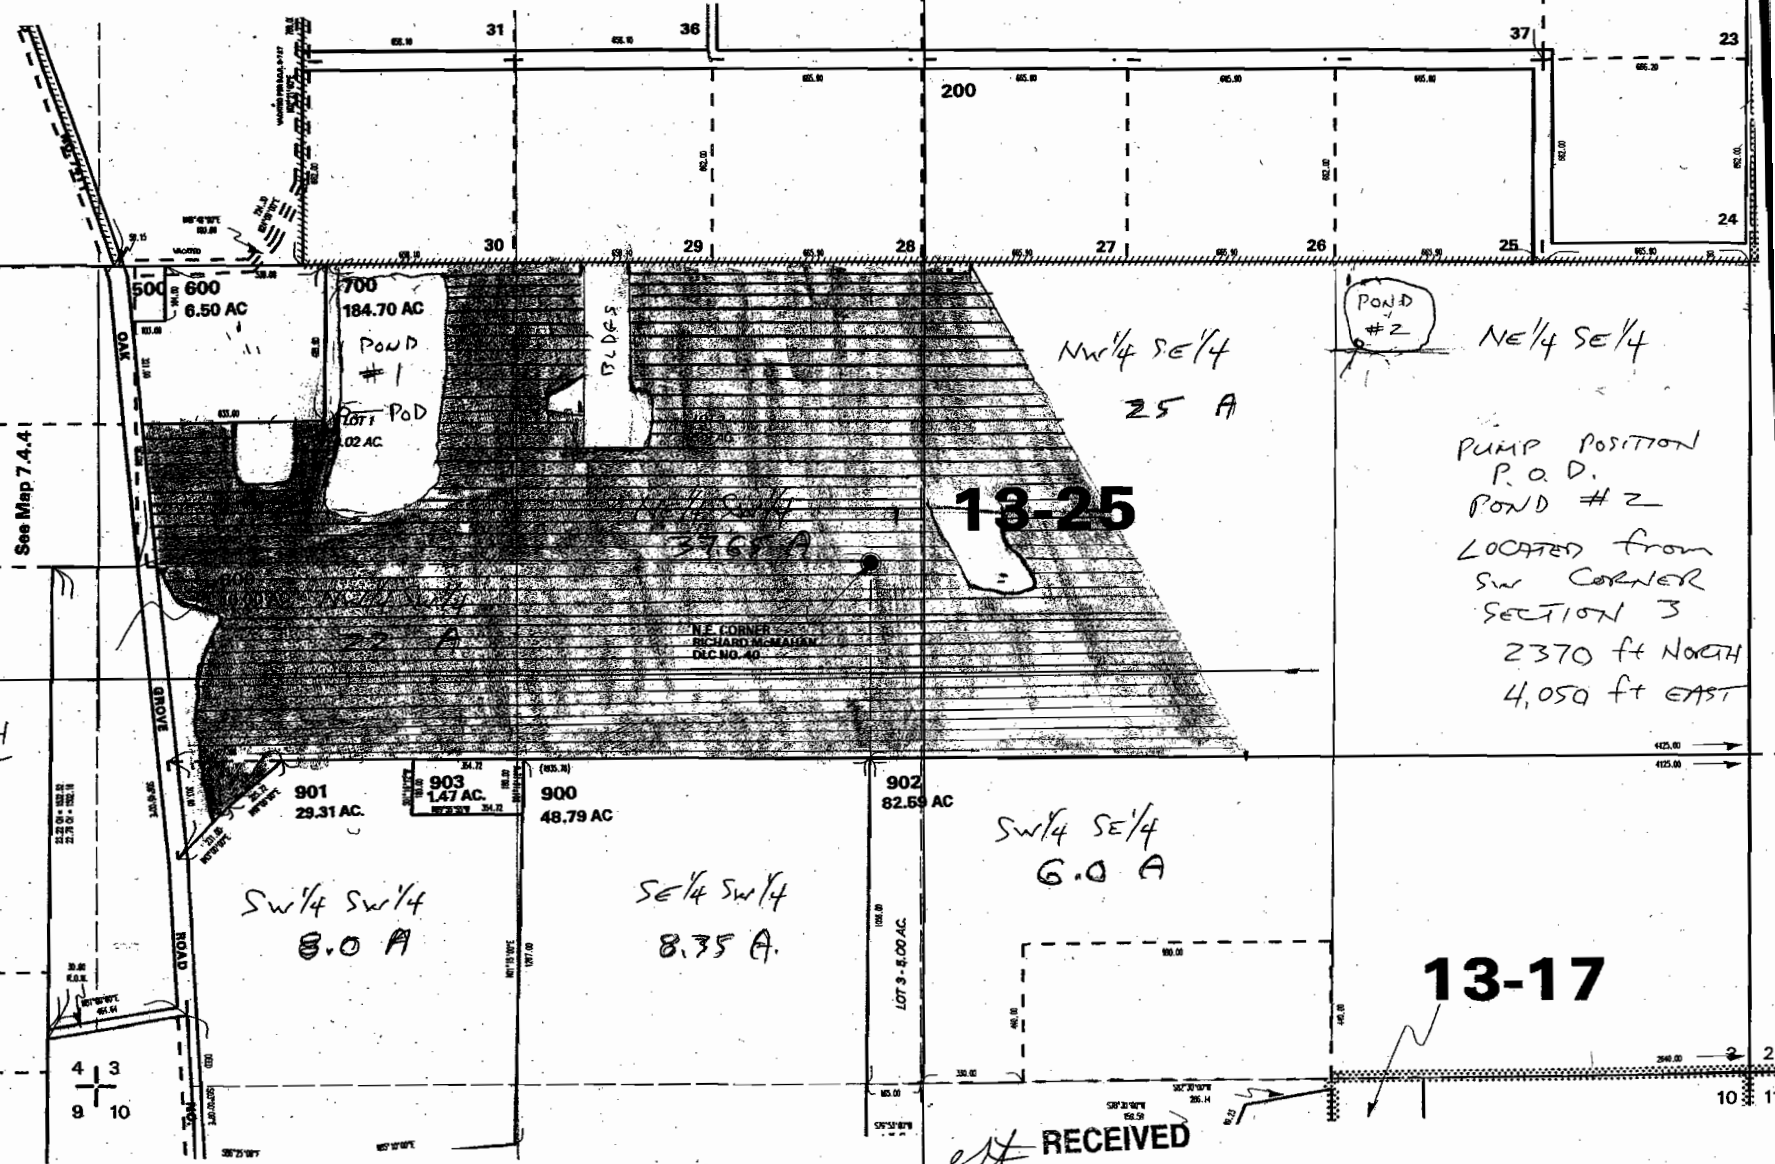

POND #2
NE 1/4 SE 1/4
PUMP POSITION
P.O.D.
POND #2
LOCATED FROM
SW CORNER
SECTION 3
2370 FT NORTH
4,050 FT EAST

SW 1/4 SE 1/4
6.0 A

SW 1/4 SW 1/4
8.0 A

SE 1/4 SW 1/4
8.35 A.

LARGE POND #1
LOCATED FROM SW CORNER
SECTION 3
950 FT EAST
2300 FT NORTH

RECEIVED
JUL 18 2005
WATER RESOURCES DEPT
SALEM, OREGON

SMALLER POND #2
LOCATED FROM SE CORNER
SECTION 3
1150 FT WEST
2350 FT NORTH