

COLLECTED  
APPROX SCALE  
1" = 400 FT.


**WORK  
COPY**

P.O.D  
PUMP POSITION  
POND #1  
LOCATED FROM  
SW CORNER  
SECTION 3  
2179 ft NORTH  
780 ft EAST

Nw 1/4 SE 1/4  
25 A

Ne 1/4 SE 1/4

PUMP POSITION  
P.O.D.  
POND #2  
LOCATED FROM  
SW CORNER  
SECTION 3  
2370 ft NORTH  
4,050 ft EAST

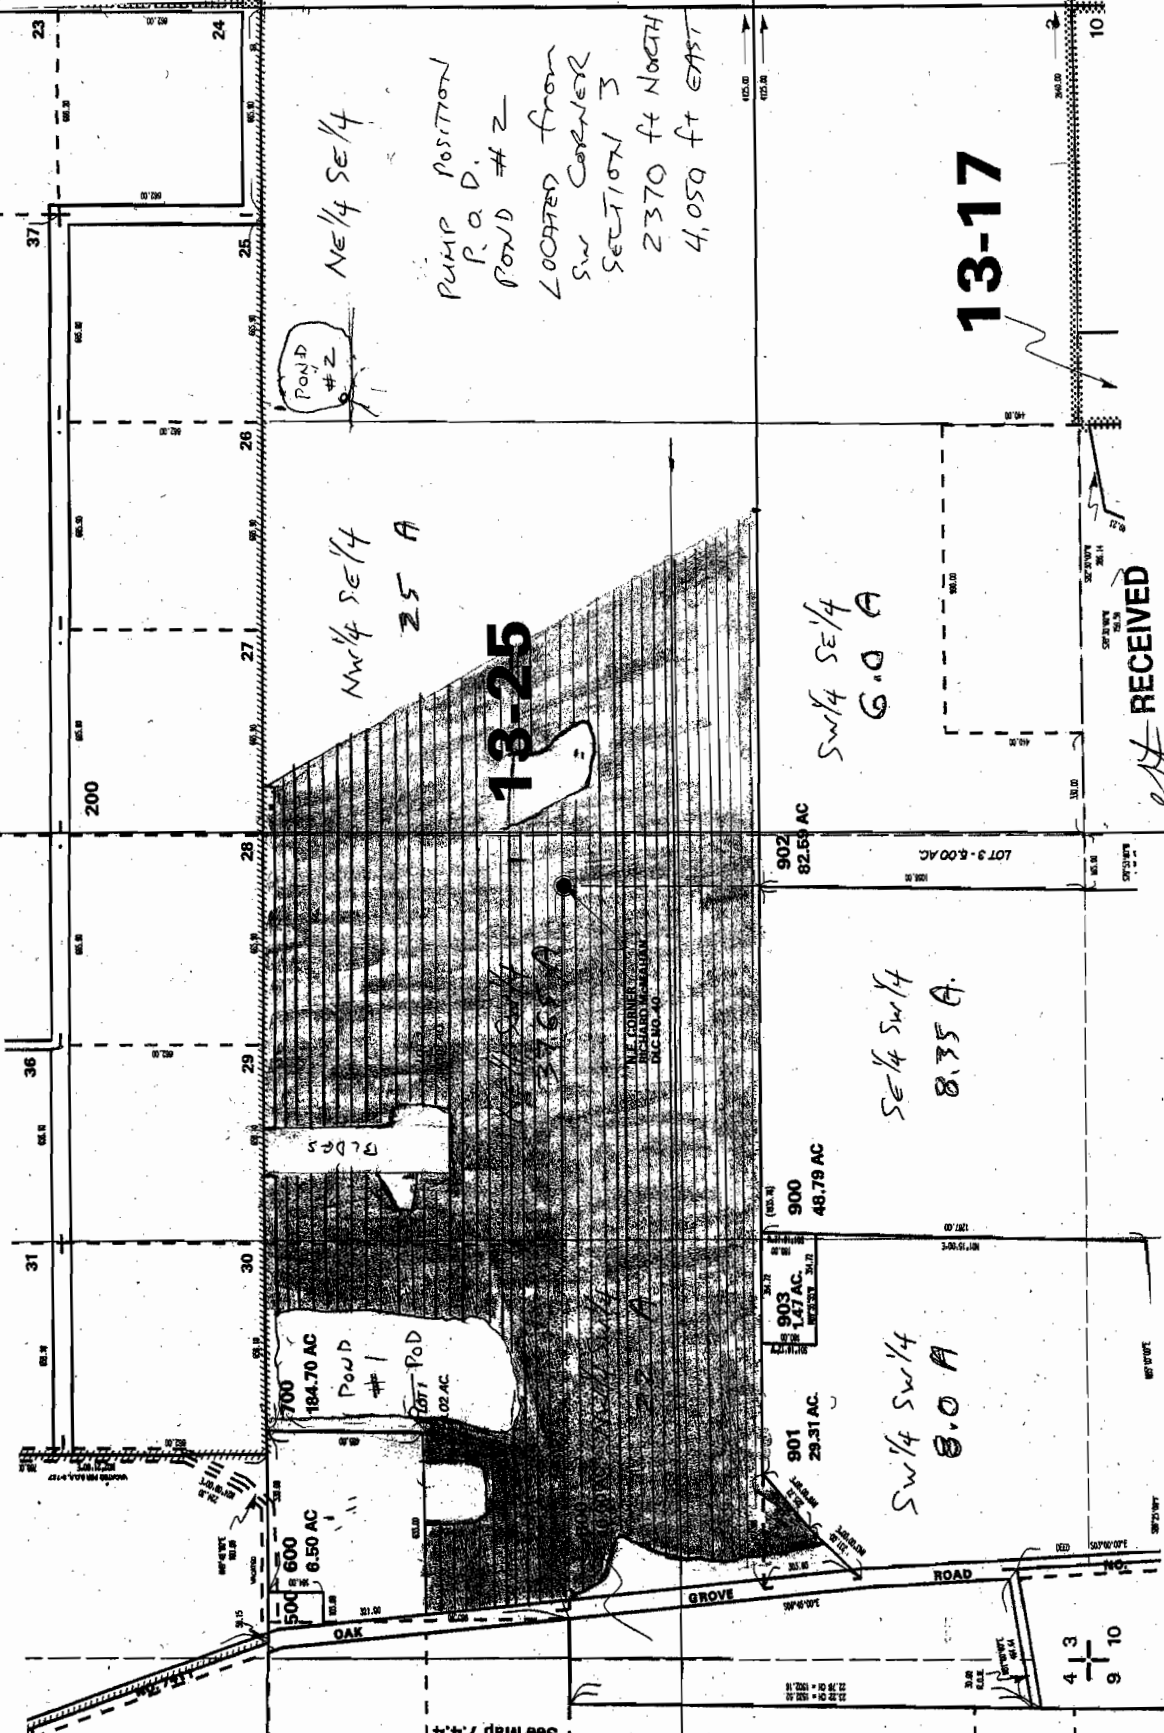

Sw 1/4 SE 1/4  
G.O A

SE 1/4 SW 1/4  
8.35 A.

Sw 1/4 SW 1/4  
8.0 A

13-17

LARGE POND #1  
LOCATED FROM SW CORNER  
SECTION 3  
950 ft EAST  
2300 ft NORTH

SMALLER POND #2  
LOCATED FROM SE CORNER  
SECTION 3  
1150 ft WEST  
2350 ft NORTH

RECEIVED  
JUL 18 2005  
WATER RESOURCES DEPT  
SALEM, OREGON

See Map 7.4.4