


WEST LINE G. EBER

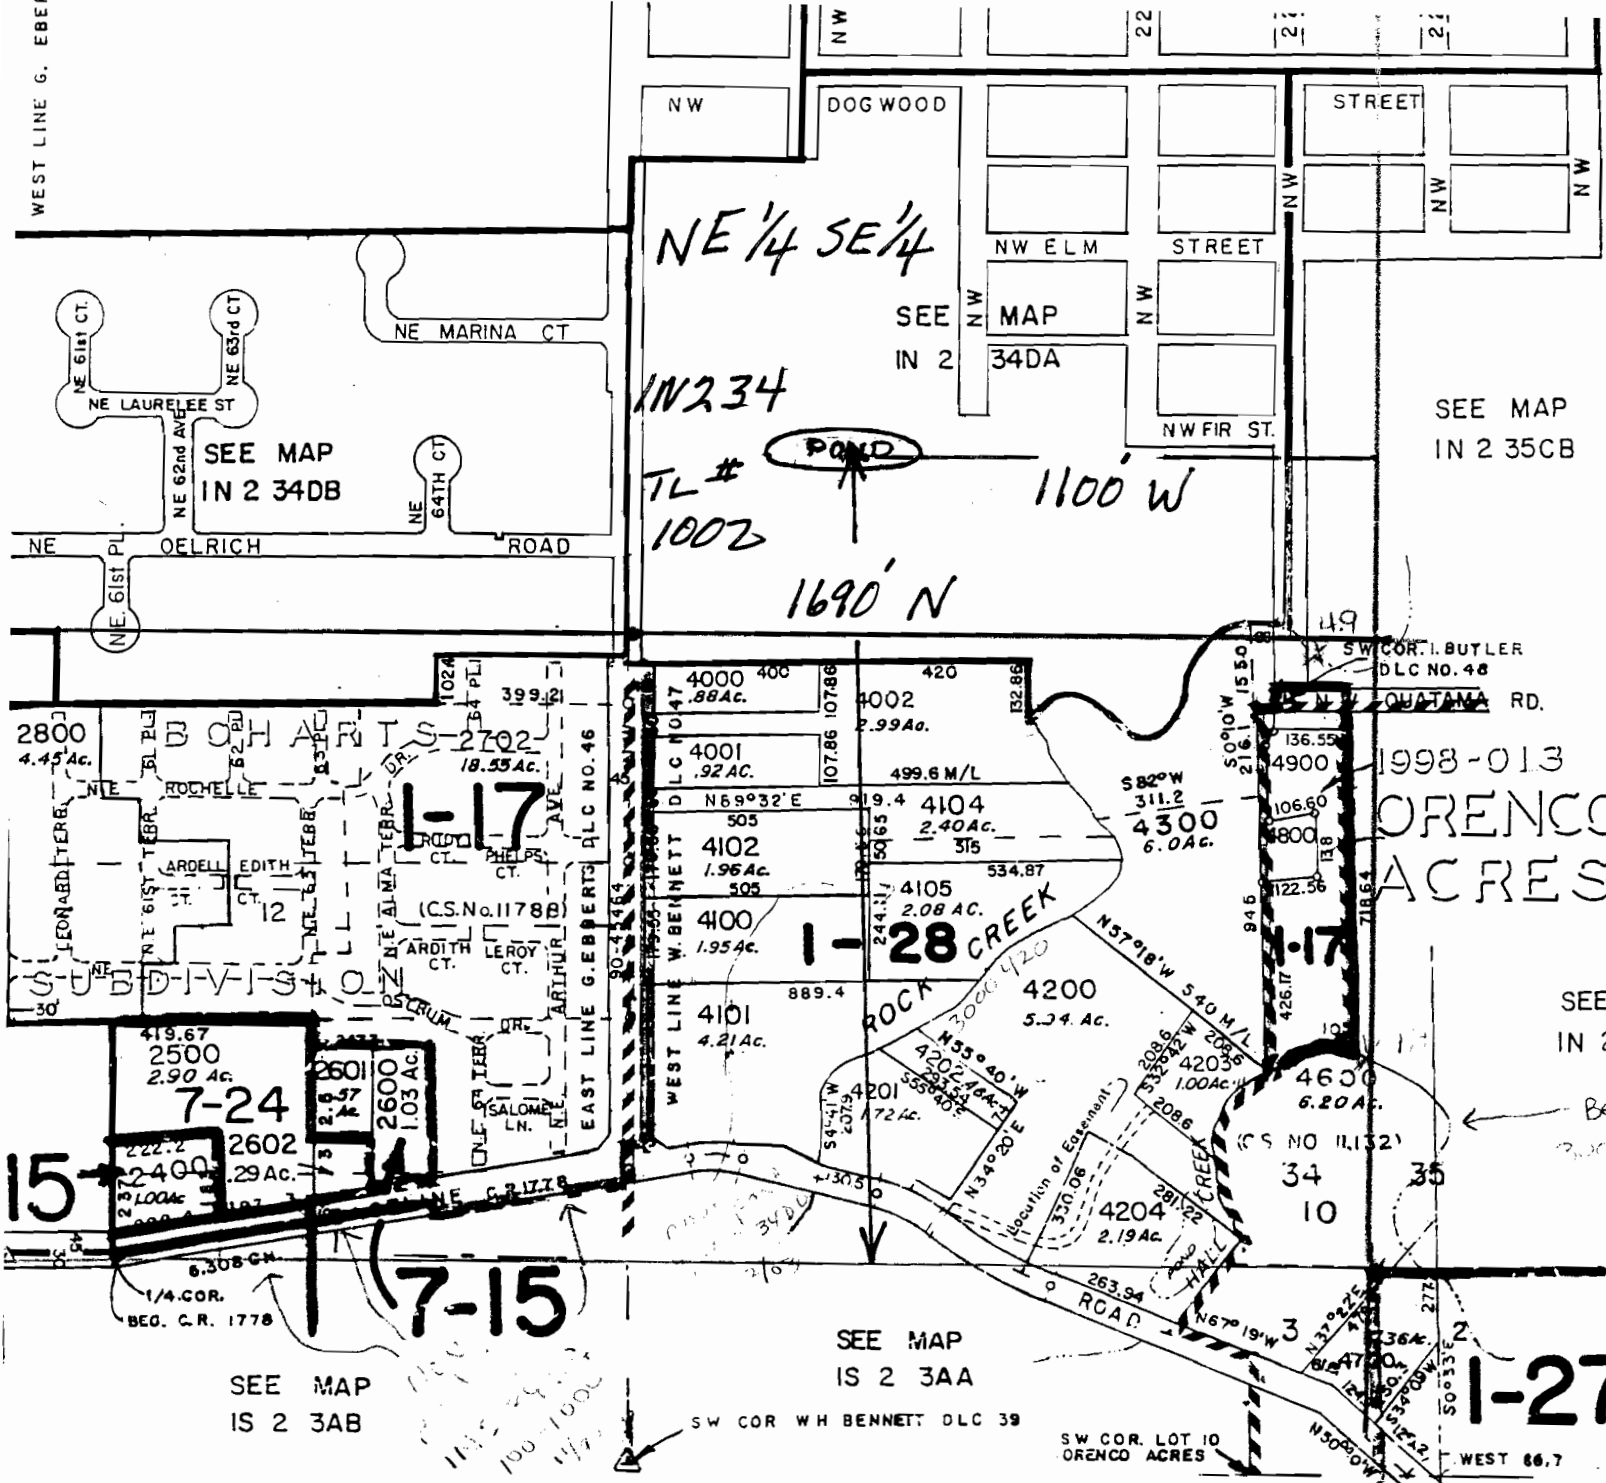

1" = 400'
 WASHINGTON
 COUNTY

1998-013
 ORENCO
 ACRES

SEE MAP
 IN 2 35CC

← Beaverton
 2000 4200 600

HILLSBORO
 & INDEX

1-27 IN 2 34

SEE MAP
 IS 2 3AA

SEE MAP
 IS 2 3AB

SW COR WH BENNETT DLC 39

SW COR. LOT 10
 ORENCO ACRES

WEST 66.7

RECEIVED
 FEB 17 2006
 WATER RESOURCES DIVISION
 SALEM, OREGON

addno B86515