



JOHN & MICHELLE ADAMS
 10252 STERLING CREEK RD

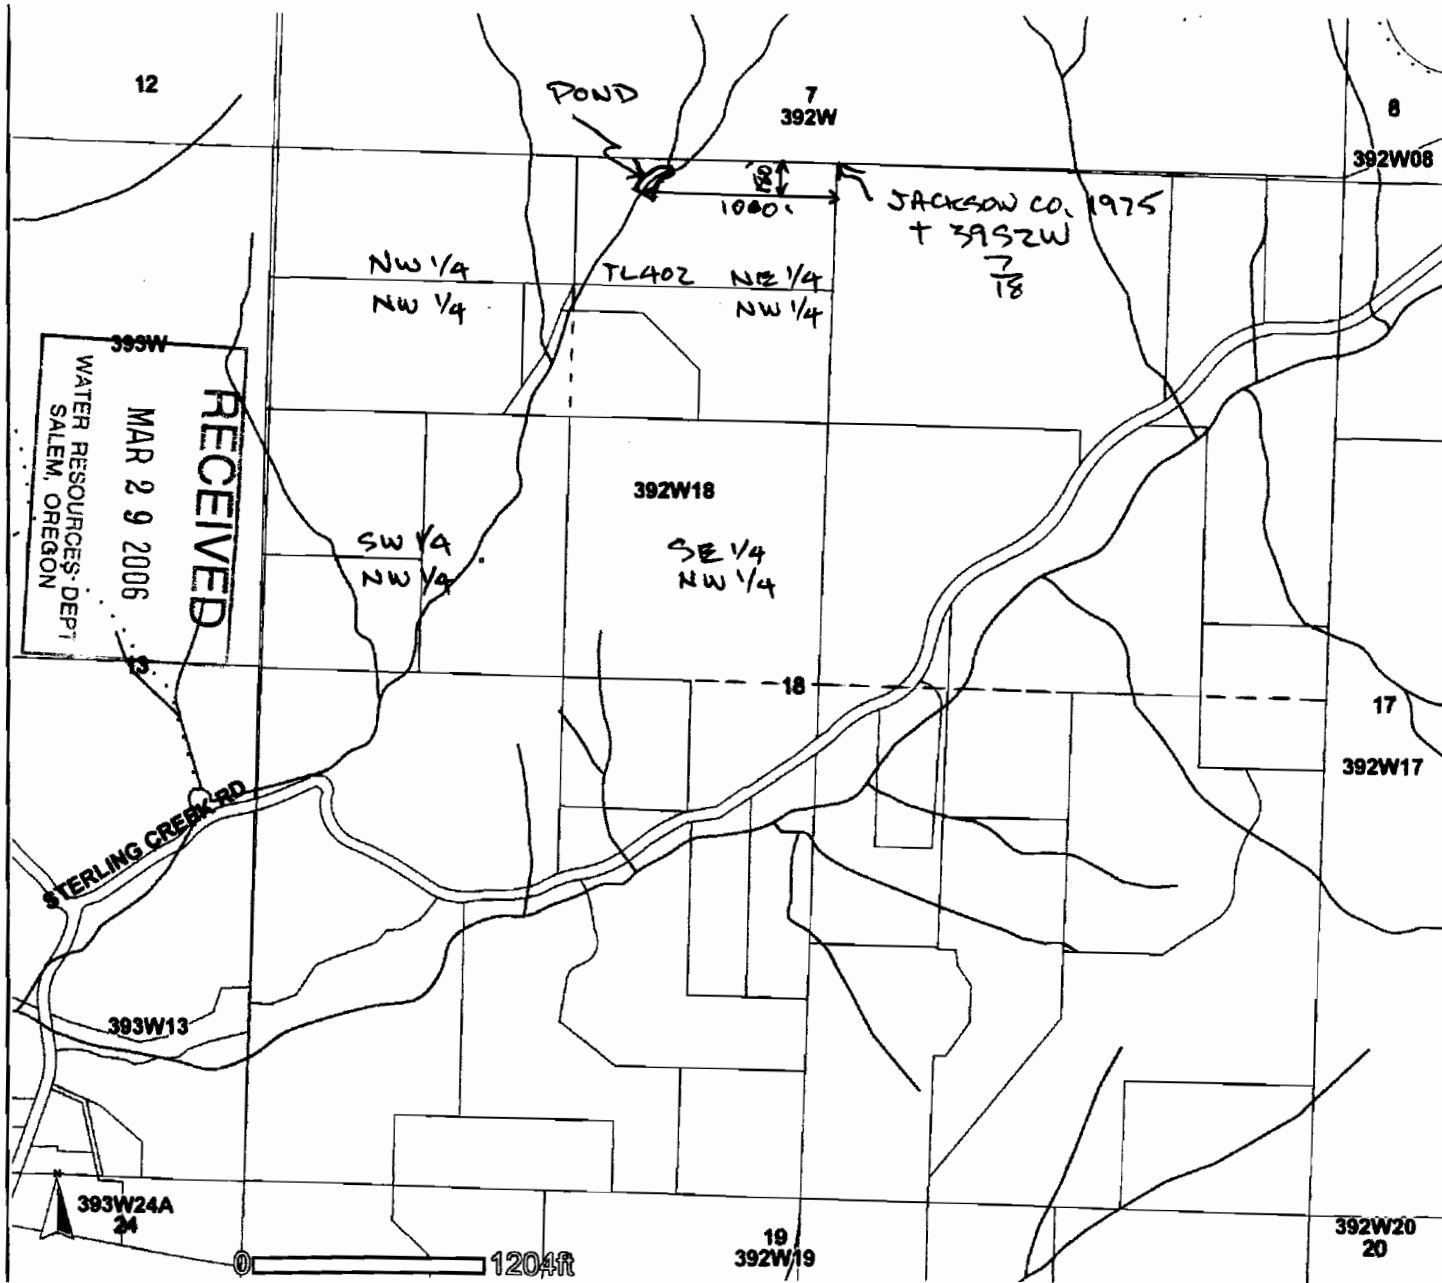

RECEIVED
 MAR 29 2006
 WATER RESOURCES DEPT
 SALEM, OREGON

Please recycle with colored office grade paper

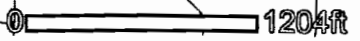

INFORMATION TECHNOLOGY

Map Maker Application

Front Counter Legend

- Tax Lot Outlines
- Streams and Ditches
- Section Outlines
- City Limits
- Auland
- Gate Posts
- Corner Posts
- Eagle Posts
- Gate Hill
- Jacksonvill
- Medford
- Phoenix
- Regae River
- Shady Cove
- Talent

T395
 RZW
 SEC 18
 TL 402
 1" = 1000 FT



This map is based on a digital database compiled by Jackson County from a variety of sources. Jackson County cannot accept responsibility for errors, omissions, or positional accuracy. There are no warranties, expressed or implied.

Created with MapMaker

Map created on 3/20/2006 6:20:08 PM using web.jacksoncounty.org

appno R-86533