


WALLOWA COUNTY

REVISED APPROX
SCALE
1" = 600 FEET

SEE MAP 35 45

RECEIVED
JAN 09 2006
WATER RESOURCES DE
SALEM, OREGON

CANCELLED NO.
200 THRU
202
302
402
500
1900
3500

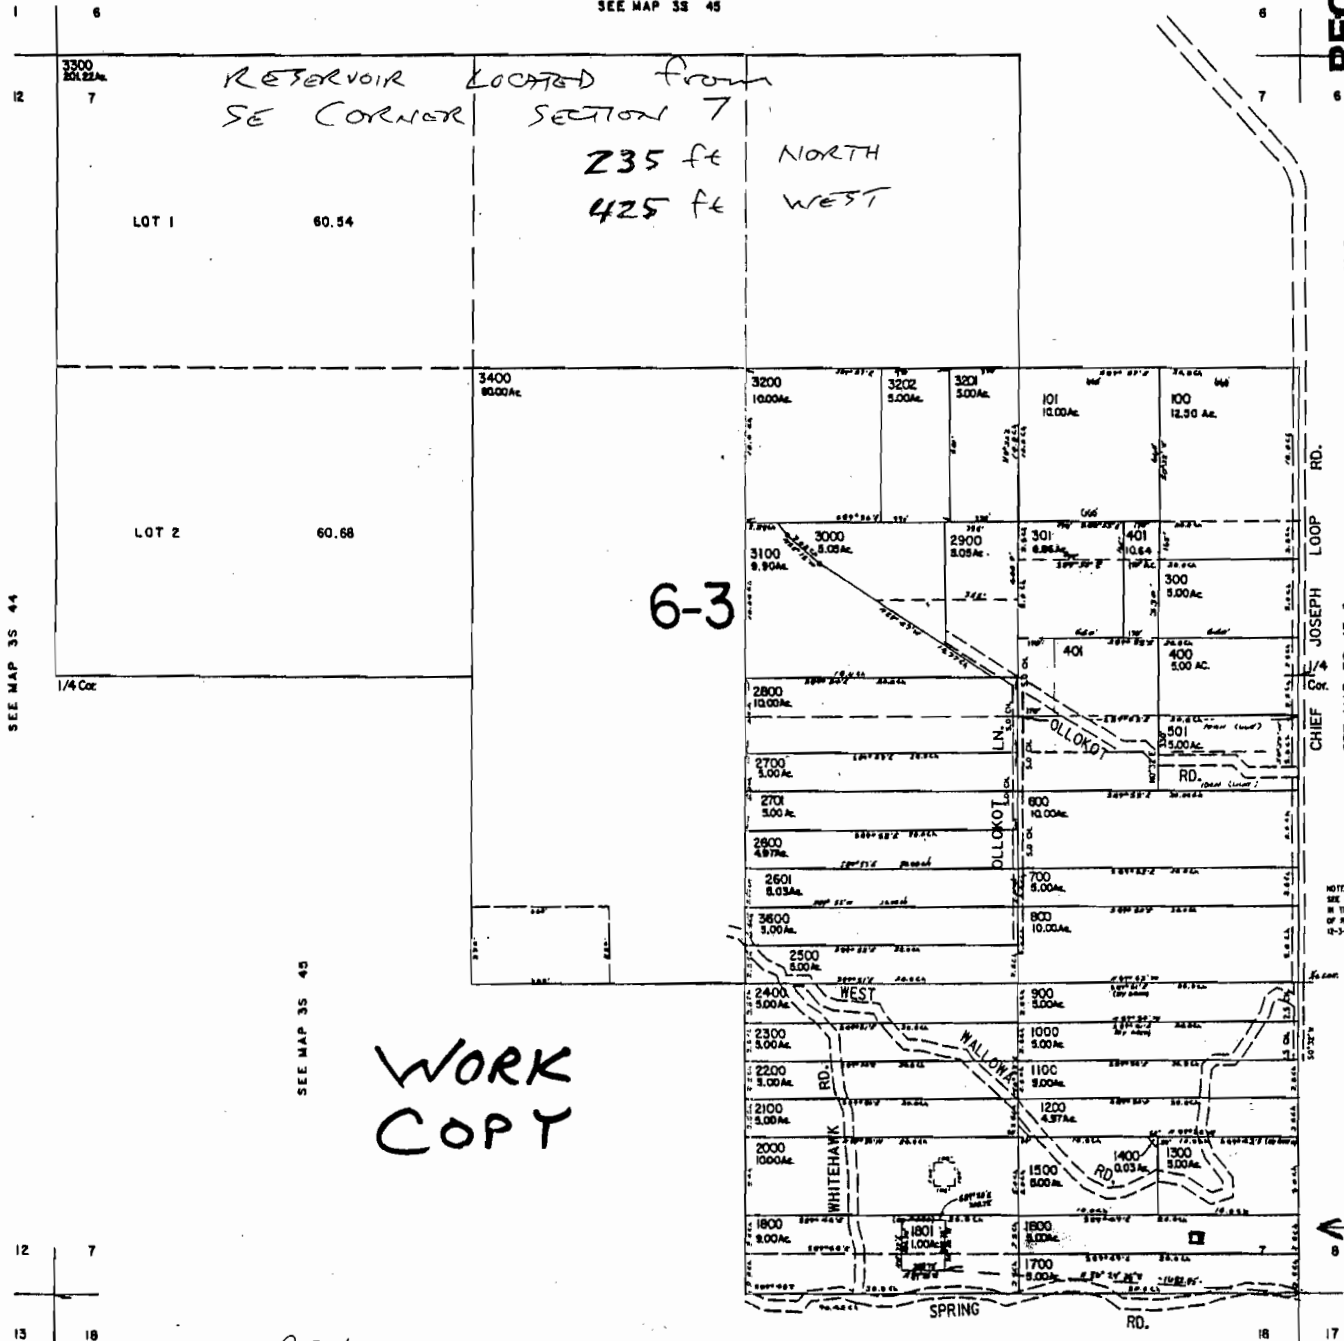

SEE MAP 35 44

SEE MAP 35 45

SEE MAP 35 45 B

SEE MAP 35 45 8CC

NOTICE
SEE ORDER 200-200
IN THE MATTER OF LEGALIZATION
OF ROADS IN THE DESIGN AREA
12-3-2001 DOCUMENT 04-097

WORK
COPY

APP NO R86474

SEE MAP 35 45

12 7
13 18


RESERVOIR MAP

John MOORE
Joseph OR.

TAX LOT 1600
35 45 7

SCALE 1" = 100'

12/30/05

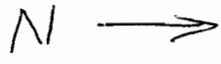

TAX LOT
1600

SPRING

RESERVOIR
NO OUTLET

18 7

17 8

STANLEY CK.

RECEIVED

JAN 09 2006

WATER RESOURCES DEPT
SALEM, OREGON

R- 06474

35 45 7