



ATT 8/20

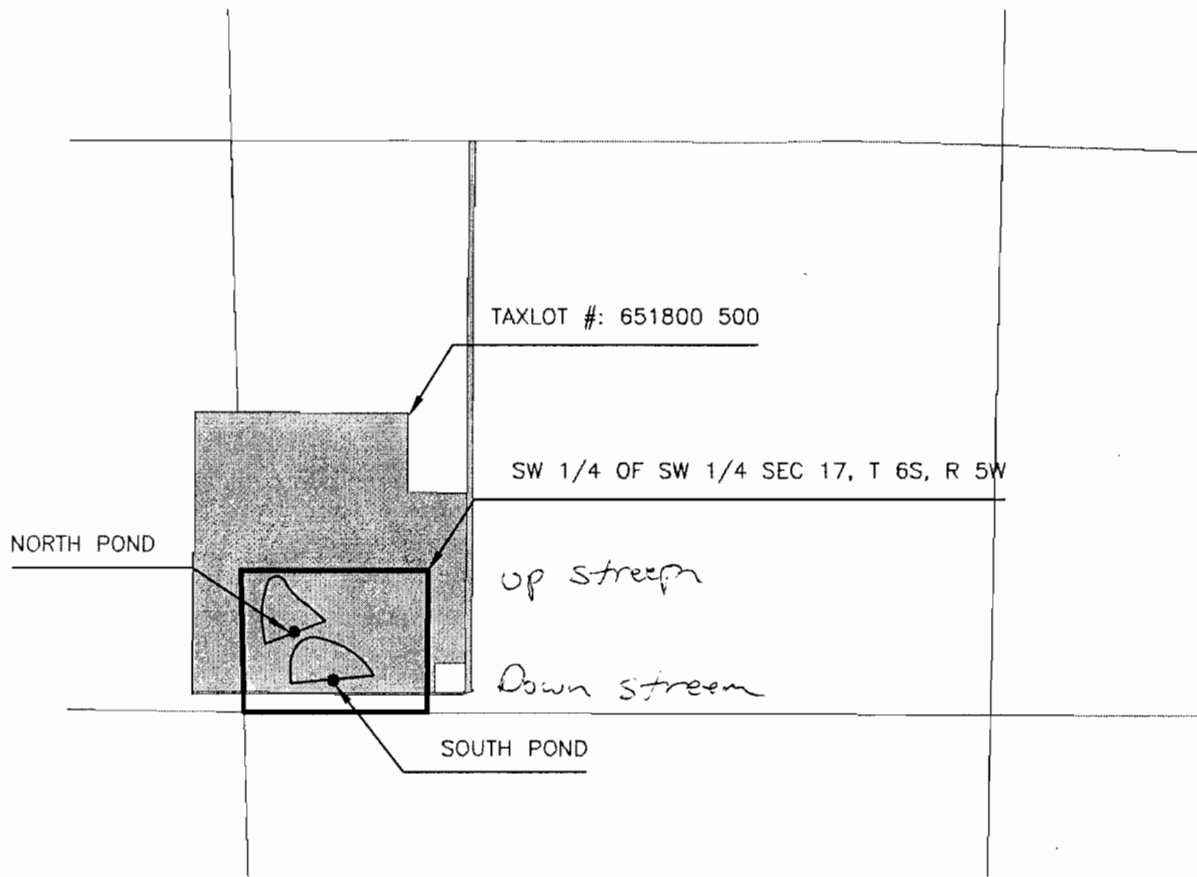

MAXSON - DUCK PONDS

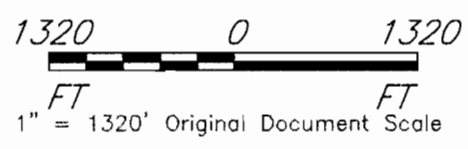

SOUTH POND is 660 ft east and 260 ft north of SW corner of section 17, T 6S, R5W, WM
 NORTH POND is 370 ft east and 590 ft north of SW corner of section 17, T 6S, R5W, WM

CMS

4/06

MAXSON
 DUCK PONDS - LOCATION MAP
 POLK COUNTY, OREGON

U.S.D.A. NATURAL RESOURCES CONSERVATION SERVICE

appno R 86577