




# T. 33 S., R. 1 E., W.M.

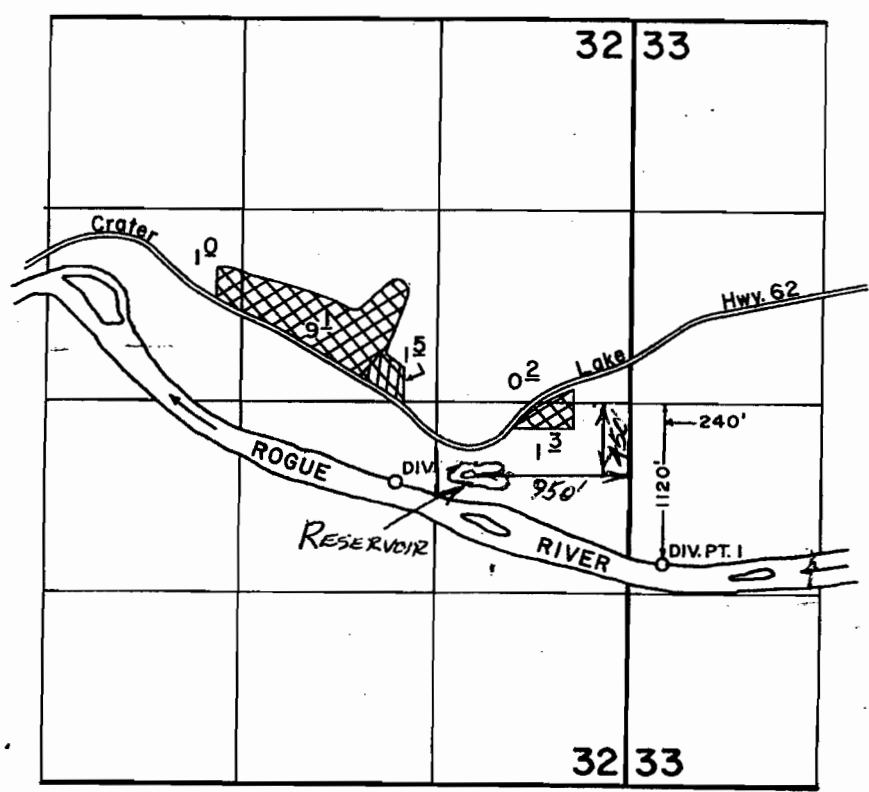

SCALE: 1" = 1320'

**Obstinate J Reservoir**  
 29680 Highway 62  
 Trail, Oregon

**RECEIVED**

JAN 17 2006  
 WATER RESOURCES DEPT  
 SALEM, OREGON

collects water during winter months  
 working irrigation pond in summer months  
 water right certificates: 46673, 66027, 66046

app no R 86481