

JOSEPHINE COUNTY

1" = 400'


SCALE 1" = 400'

T35S R7W Sec 13



SEE MAP

7 12

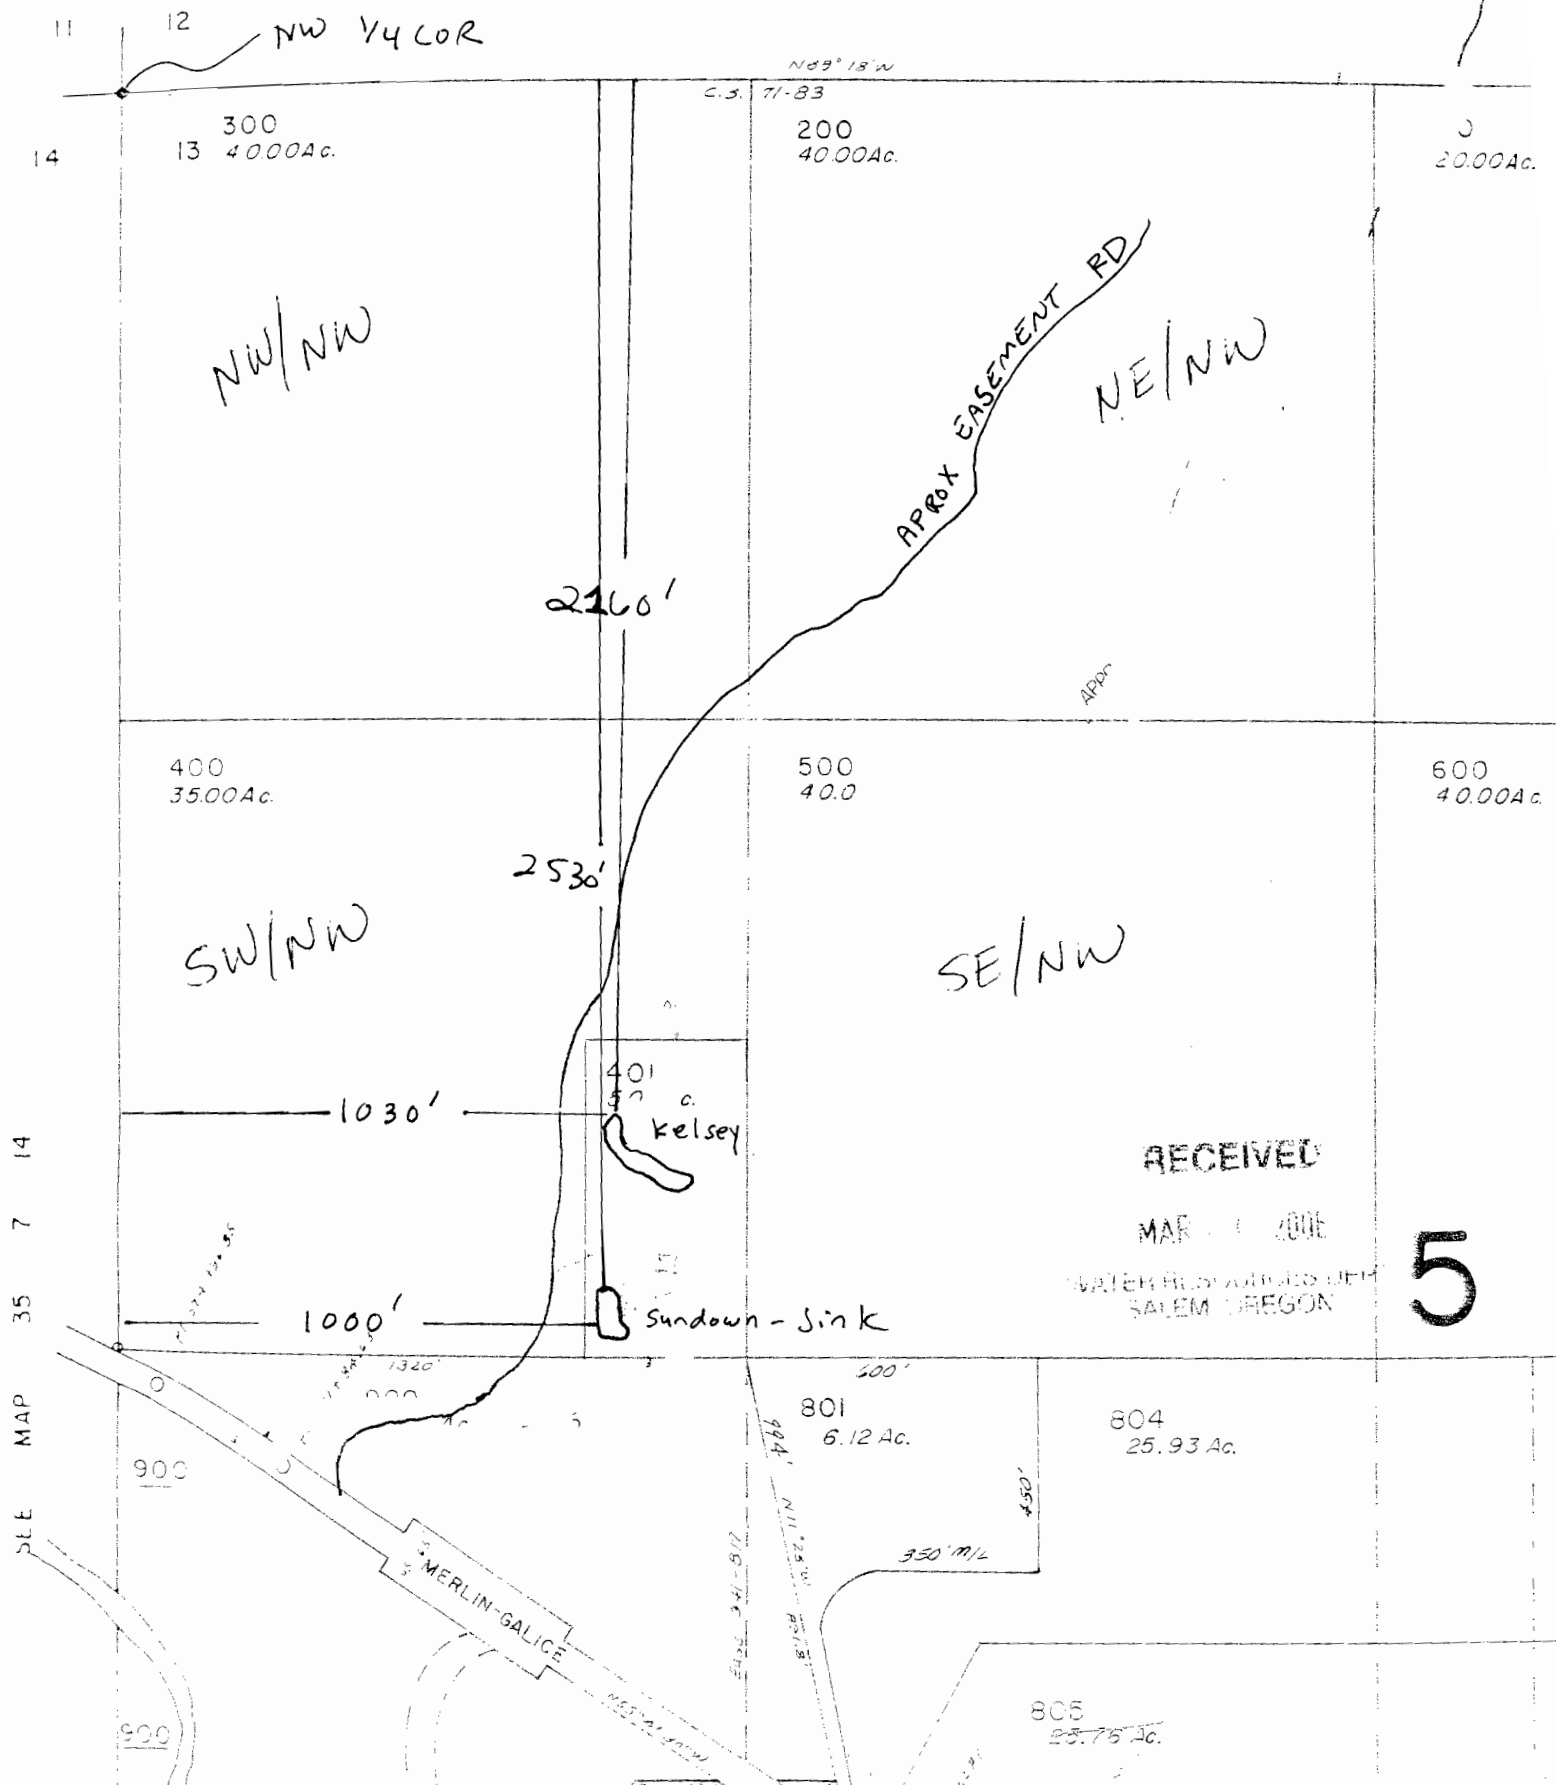

RECEIVED

MAR 1 2001

WATER RESOURCES DEPT SALEM OREGON

5

14  
7  
35  
MAP